

REDLINE

Vita Pacheco 7/7/22

Boarder Key
 ----- Kiss-cut tab
 ——— Label edge


D

NOTES:

1. Use 3M adhesive 467MP or 9667MP.
2. Subsurface printing only.
3. Background is white.
4. Match colors of graphics with provided graphic file.
5. One label per lot is to be inspected.
6. Perform inspection using SID-0000000212.
7. A Certificate of Conformance and RoHS statement is required for the material.

All material must be RoHS compliant

C

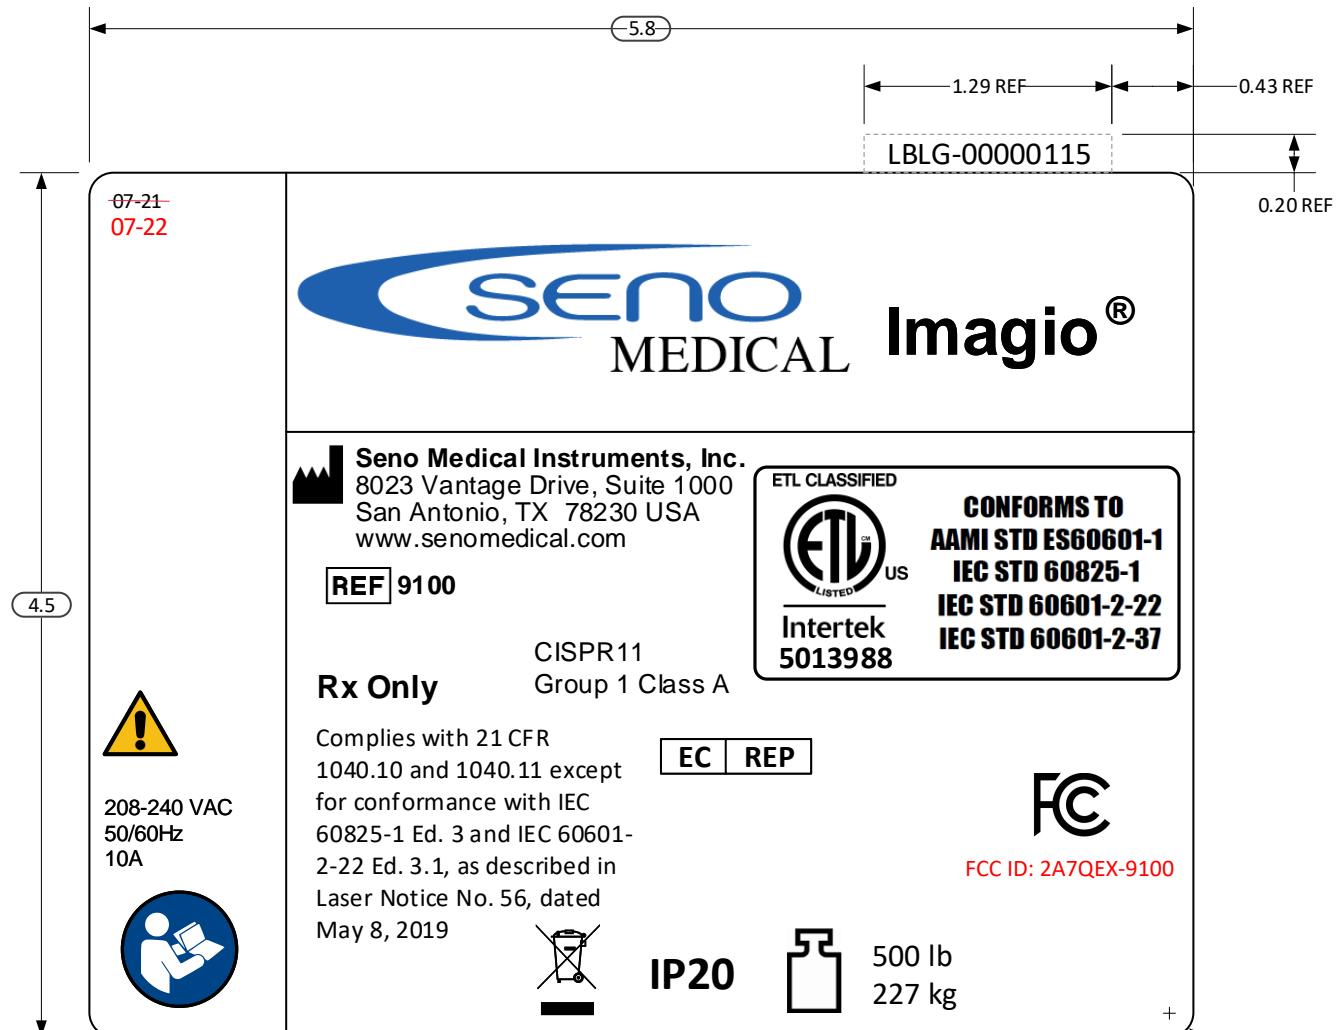

B

REVISION HISTORY		
REV	DESCRIPTION	DATE
1	INITIAL RELEASE	10/27/2020
2	UPDATED REF NUMBER	2/5/2021
3	REMOVED DUPLICATE VOLTAGE INFO, ADDED IP RATING NUMBER, UPDATE TOLERANCES	4/7/2021
4	REMOVED CE MARK AND EMERGO EUROPE INFORMATION	--

A

UNLESS OTHERWISE SPECIFIED		PROPRIETARY AND CONFIDENTIAL THE INFORMATION CONTAINED IN THIS DRAWING IS THE SOLE PROPERTY OF SENO MEDICAL INSTRUMENTS. ANY REPRODUCTION IN PART OR AS A WHOLE WITHOUT THE WRITTEN PERMISSION OF SENO MEDICAL INSTRUMENTS IS PROHIBITED.	TITLE Label, Imagio Nameplate DWG. NO. LBLG-00000115 REV. 5 SCALE: N/A DRAWN IN VISIO Sheet 1 of 1
Drawn By	V. Pacheco		
MATERIAL	0.007" Thk Polycarbonate		
FINISH	N/A		