

A

B

C

D

E

F

EA5968-04

2

H

1

2

3






4

1

2

3

4

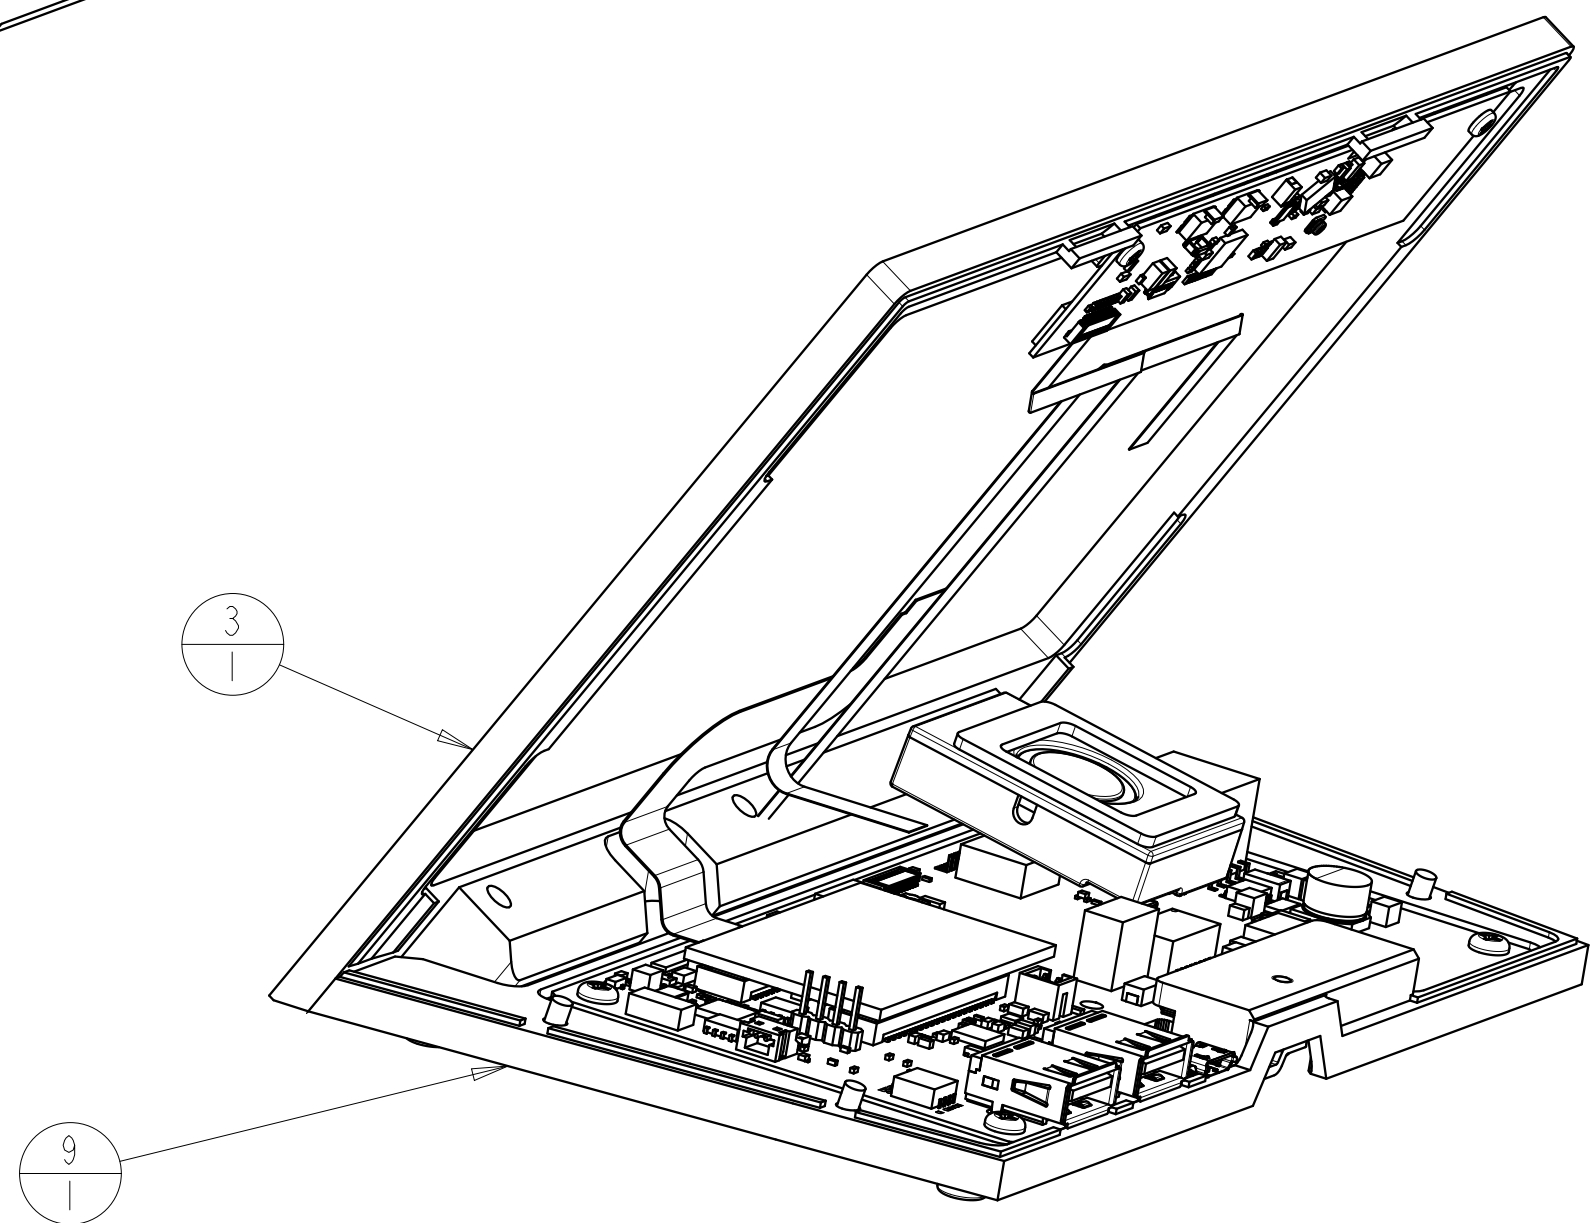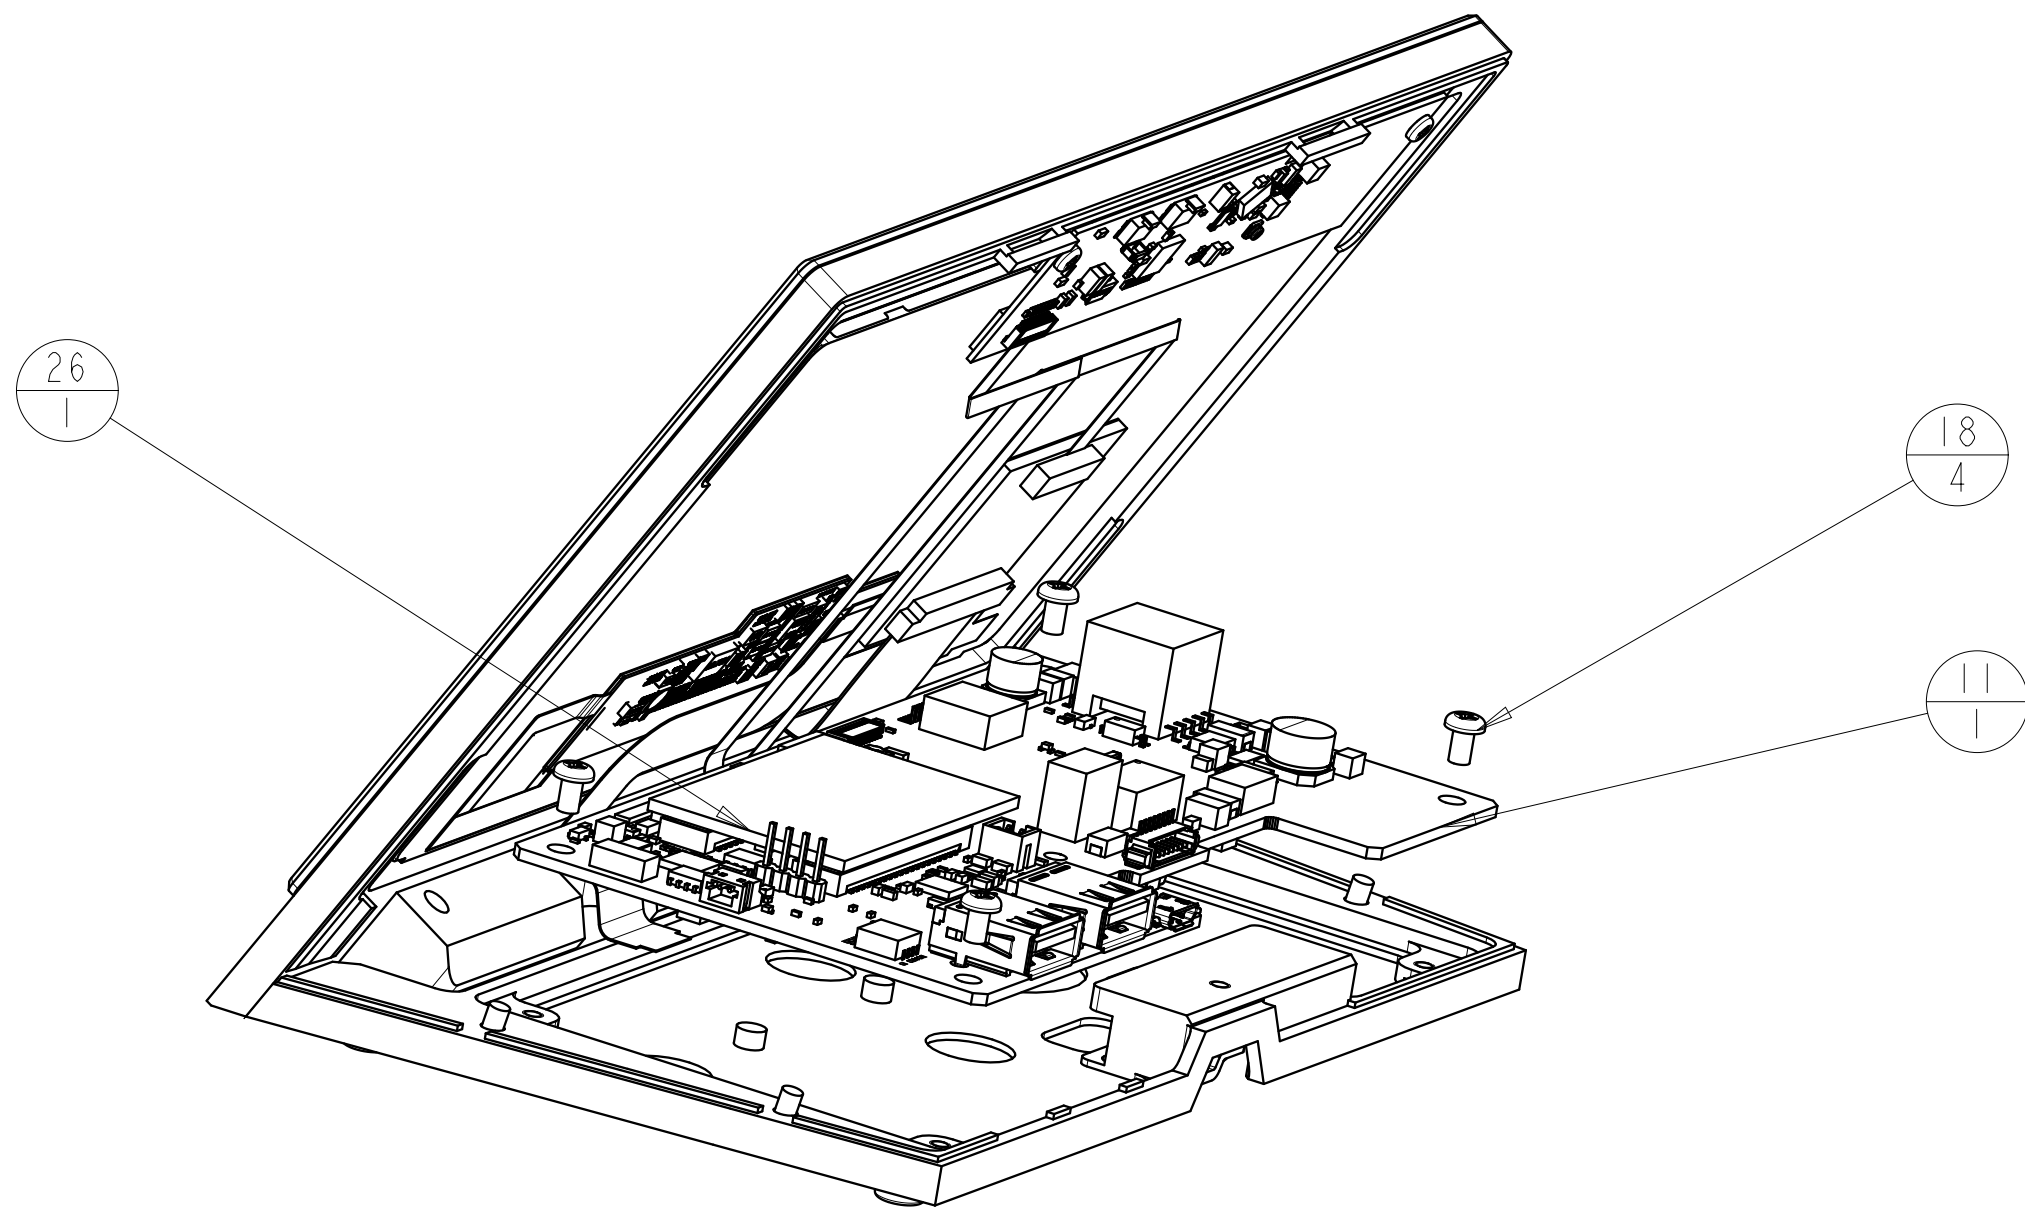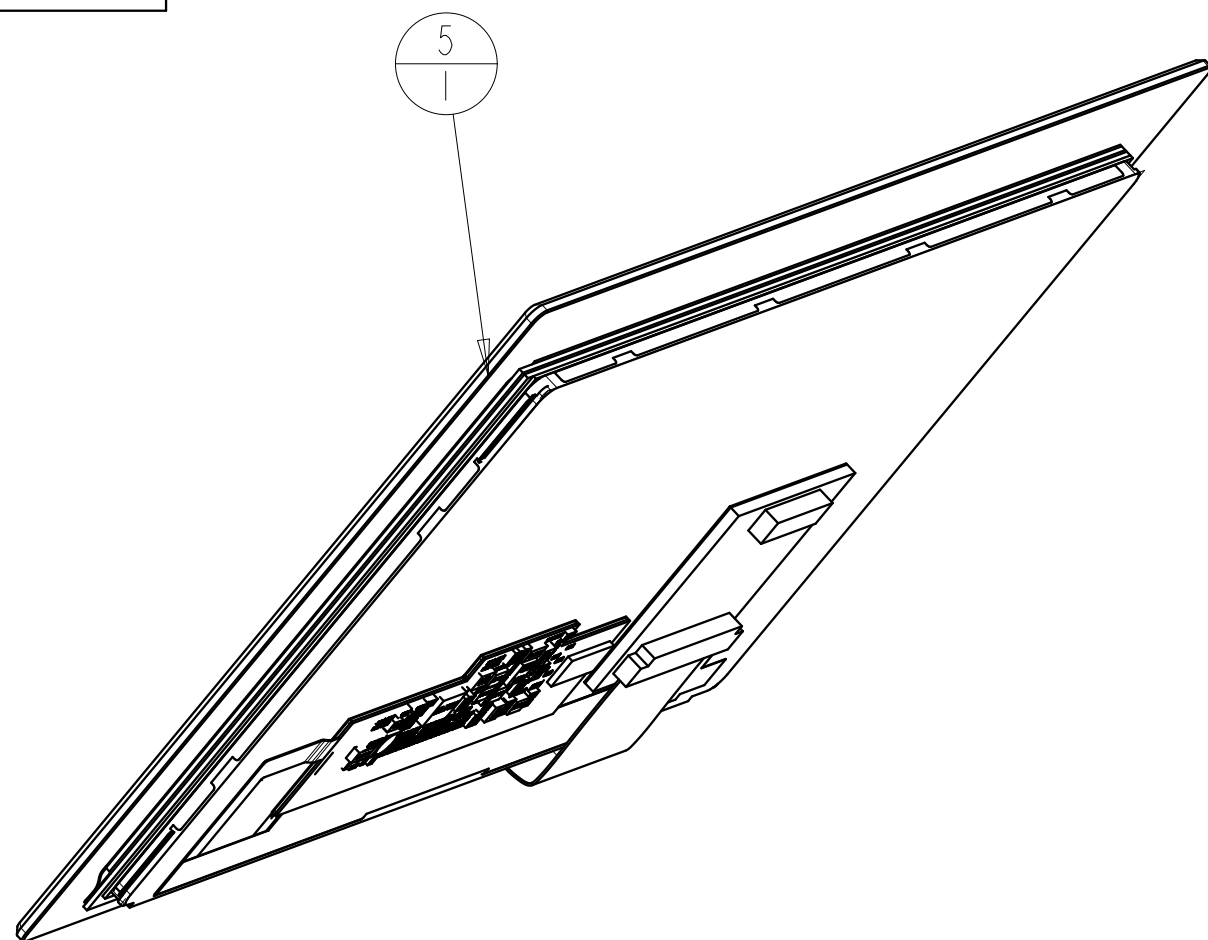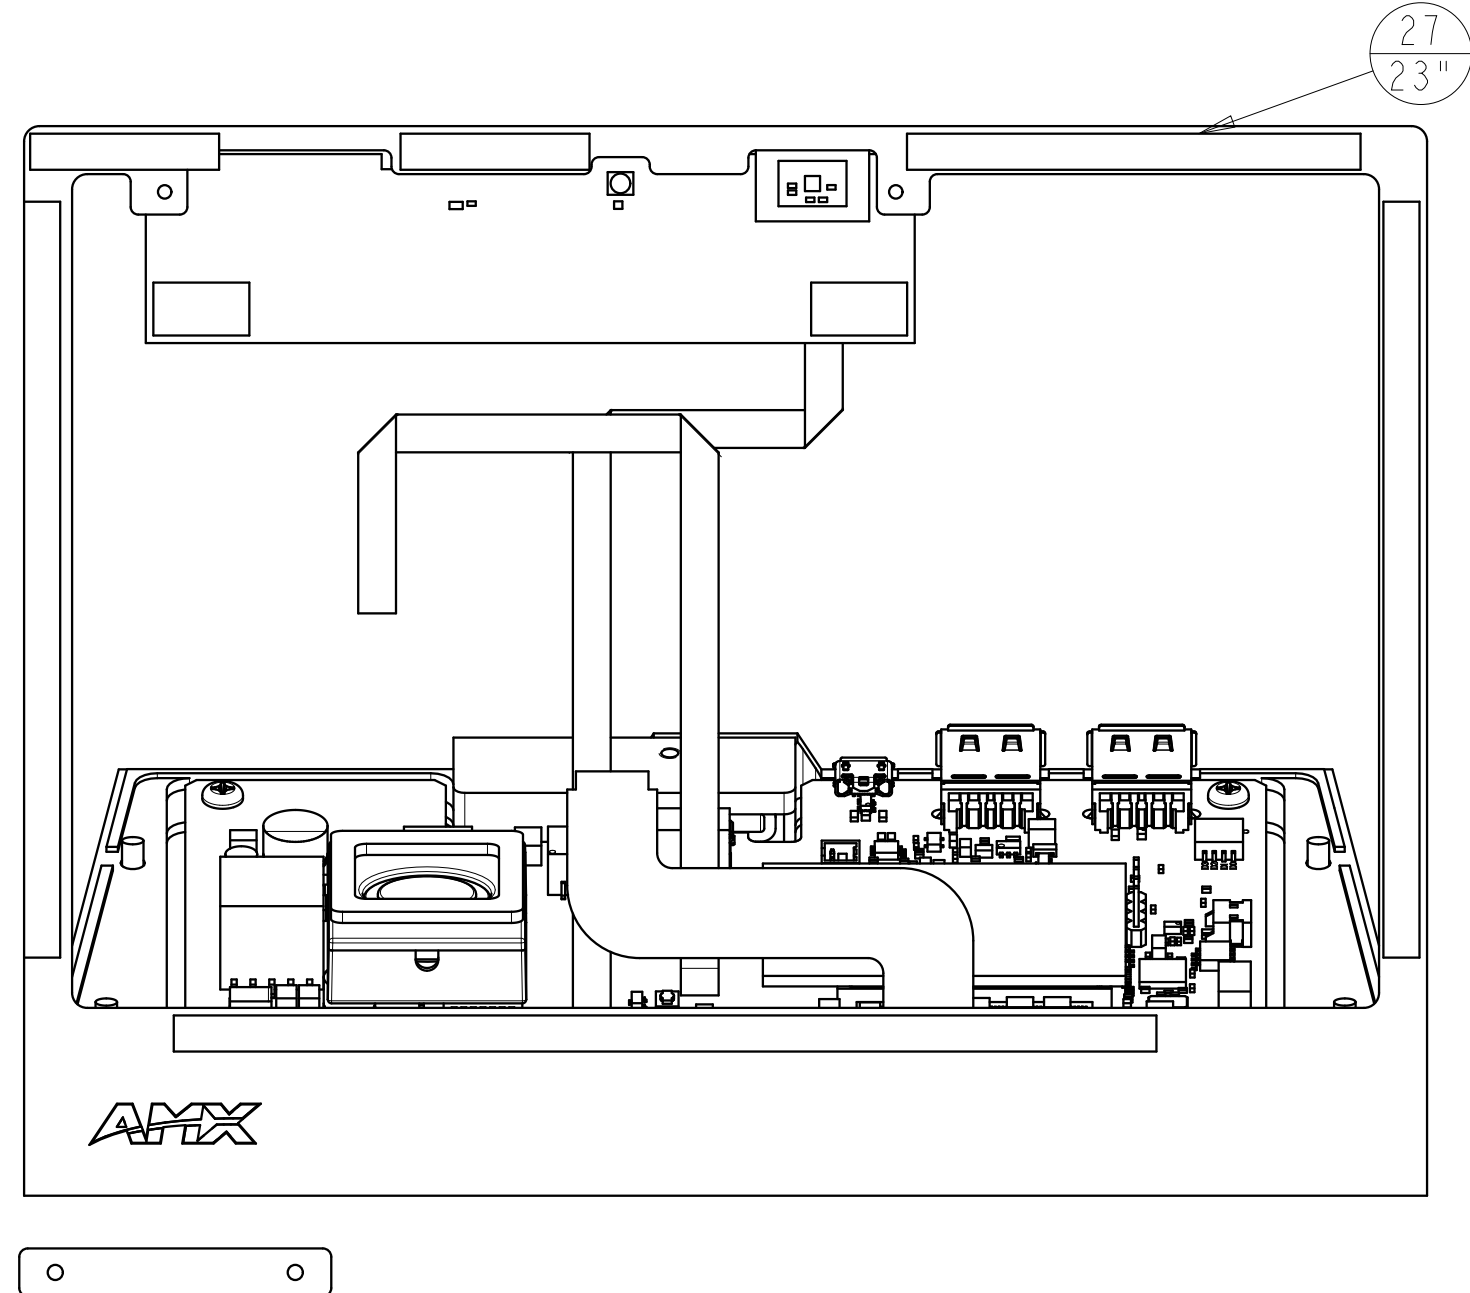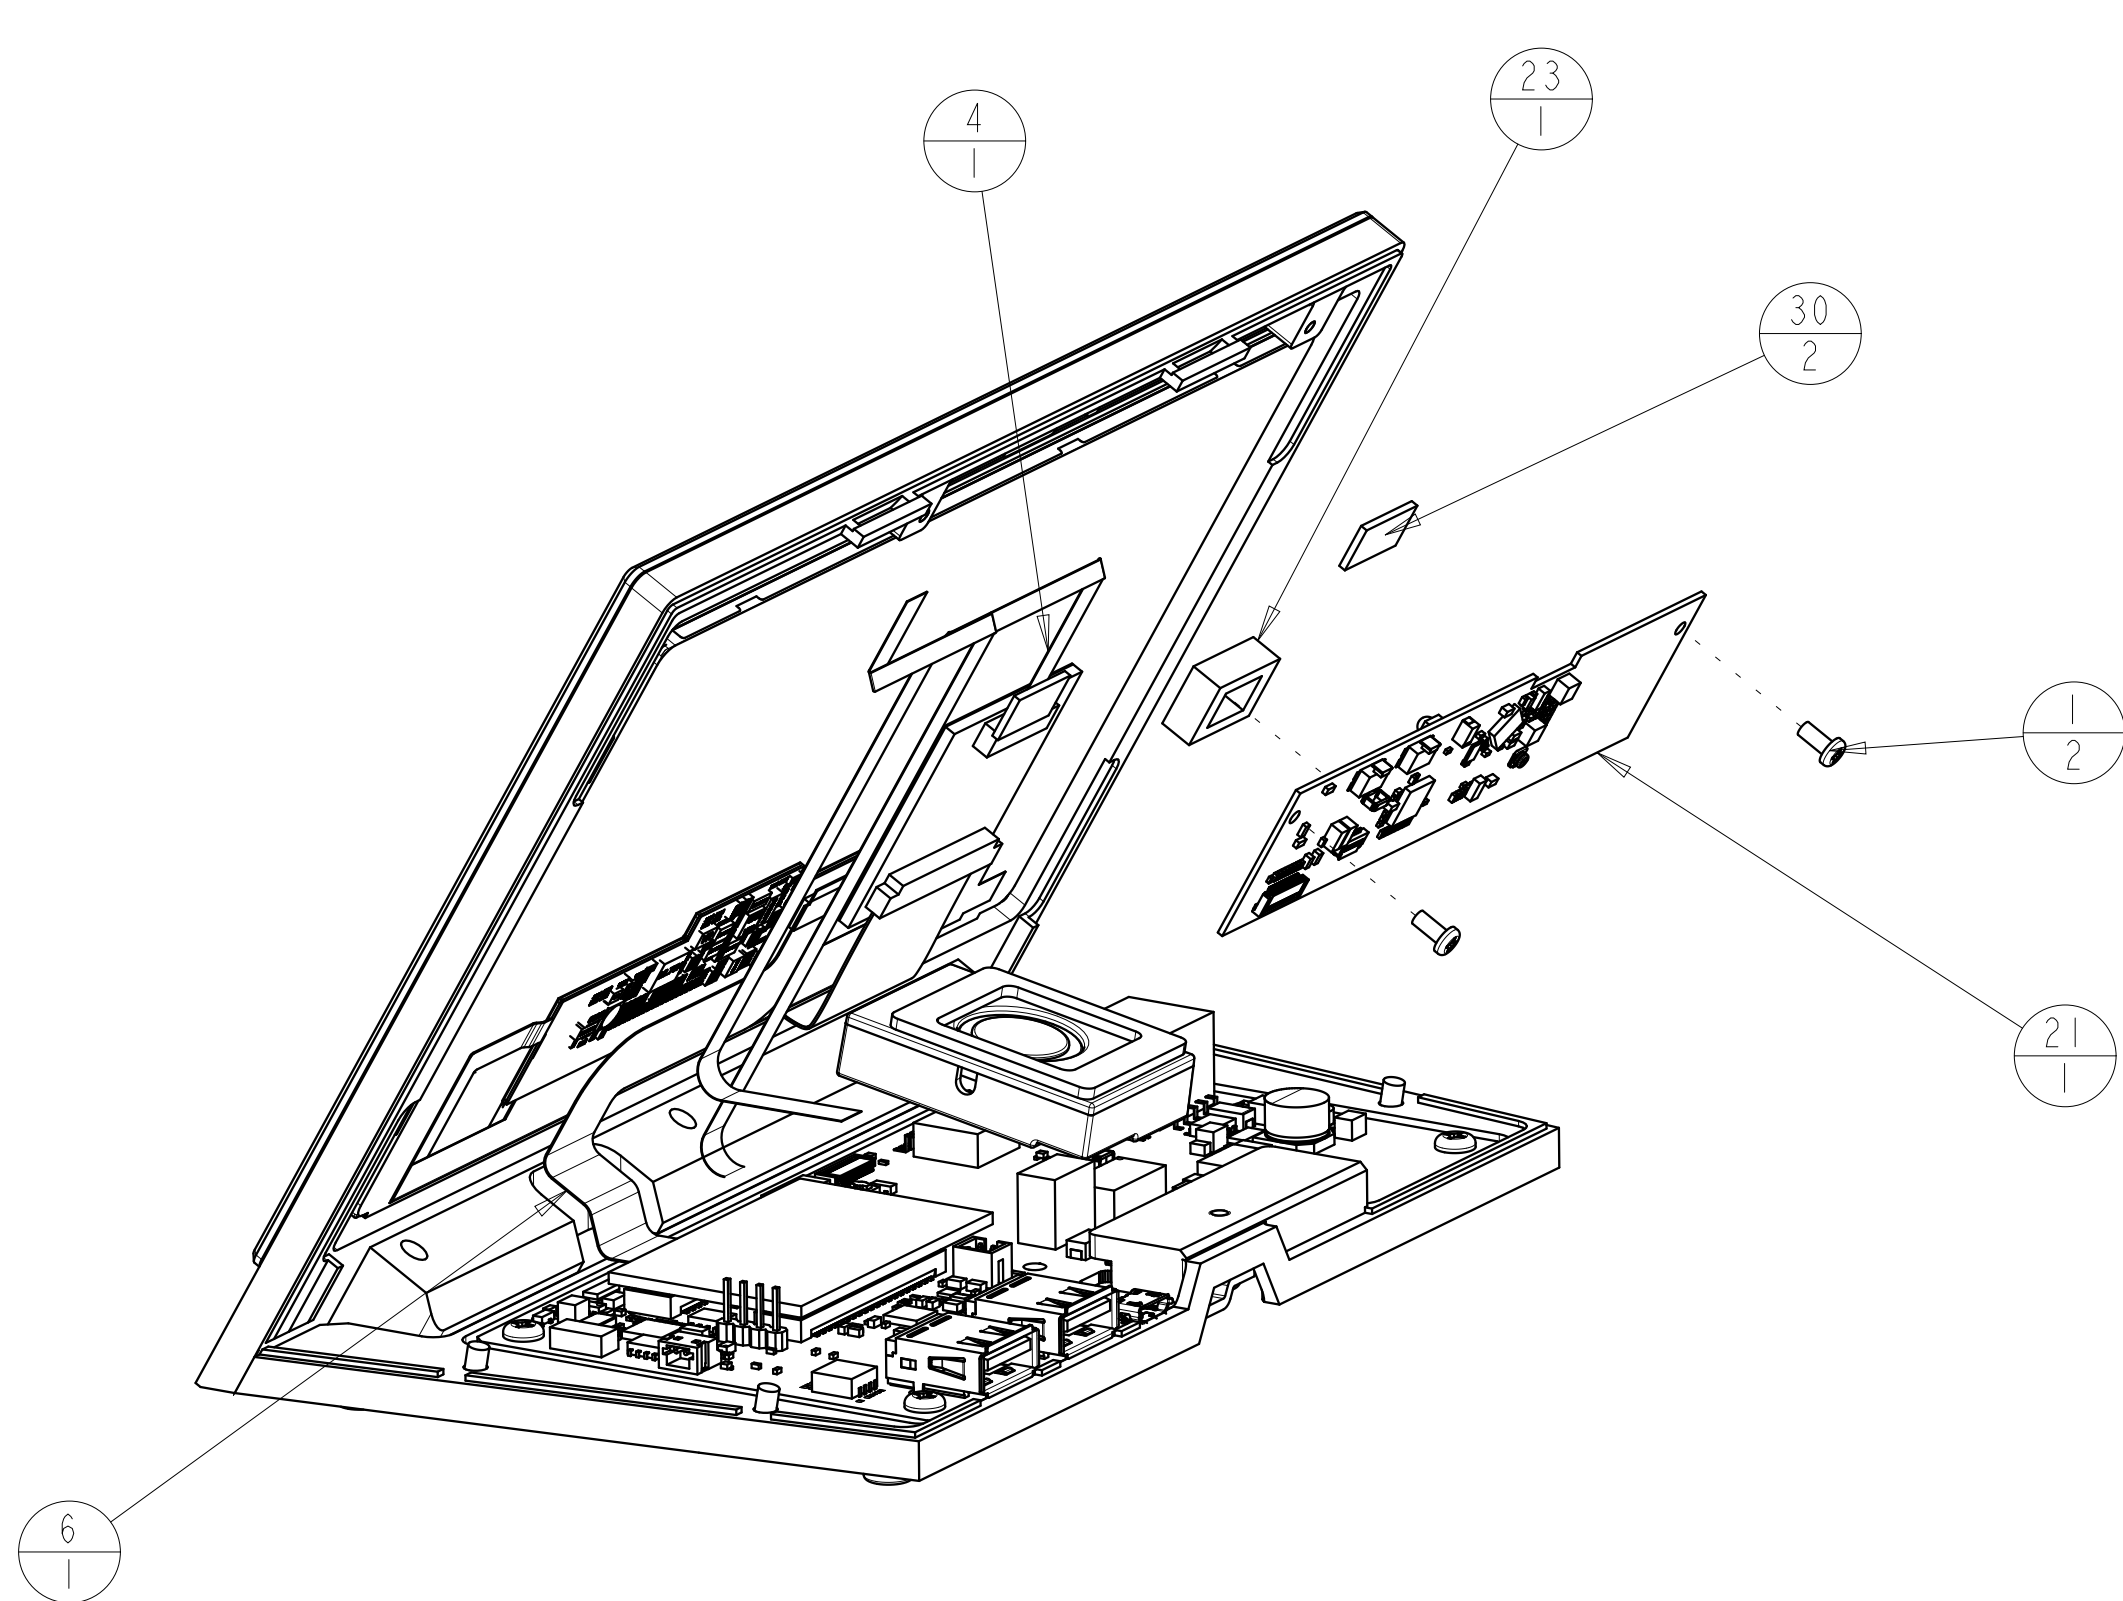

NOTICE: This drawing is the property of AMX LLC. All information contained herein this is not generally known shall be confidential except to the extent the information had been previously established. This drawings may not be copied, reproduced, or used as the basis for manufacture or sale without written permission.



AMX LLC
3000 RESEARCH DRIVE
RICHARDSON, TX 75082

ENGINEERING ASSEMBLY,
TOUCH PANEL,
7" MODERO PANORAMIC TABLETOP

SIZE

D

DRAWING
NUMBER

EA5968-04

SCALE 1:000

SHEET

2 OF 3

Q-R1
REV

M-R1

N-R1

P-R1

A

B

C




D

E


F

G

H

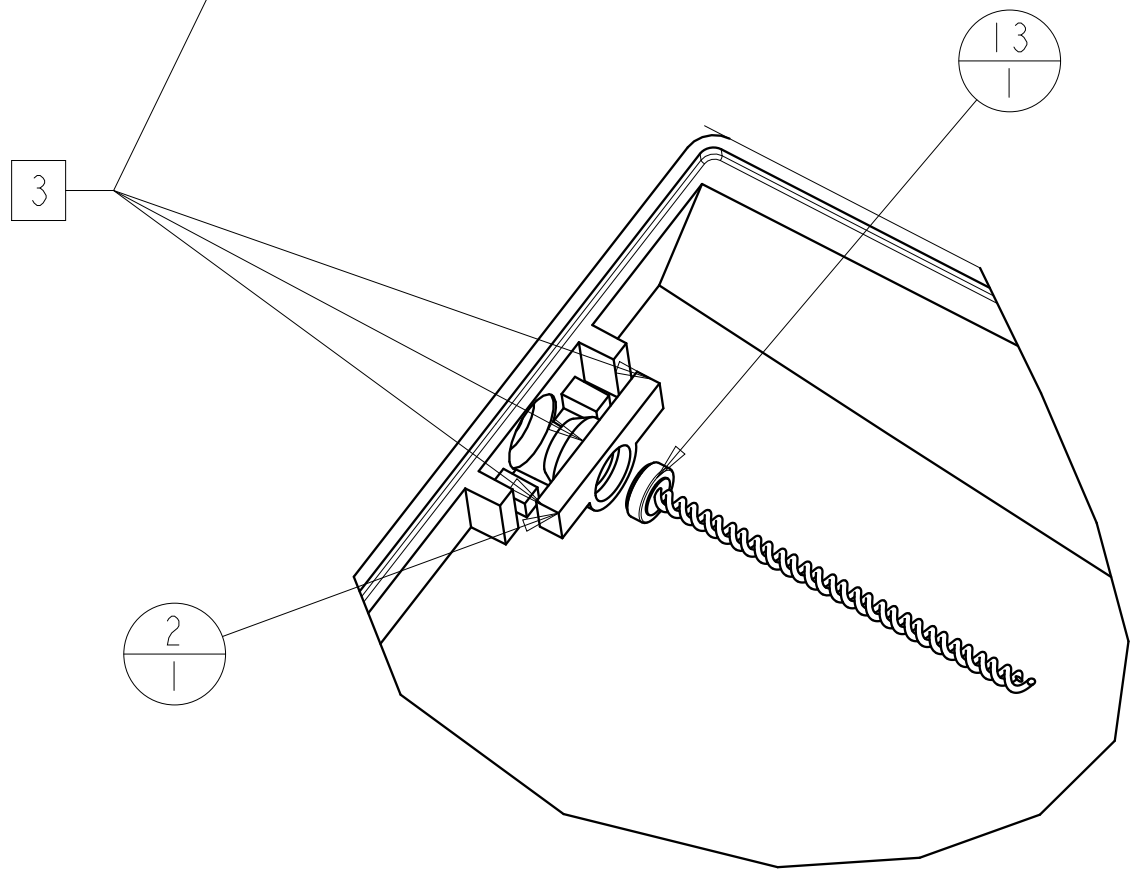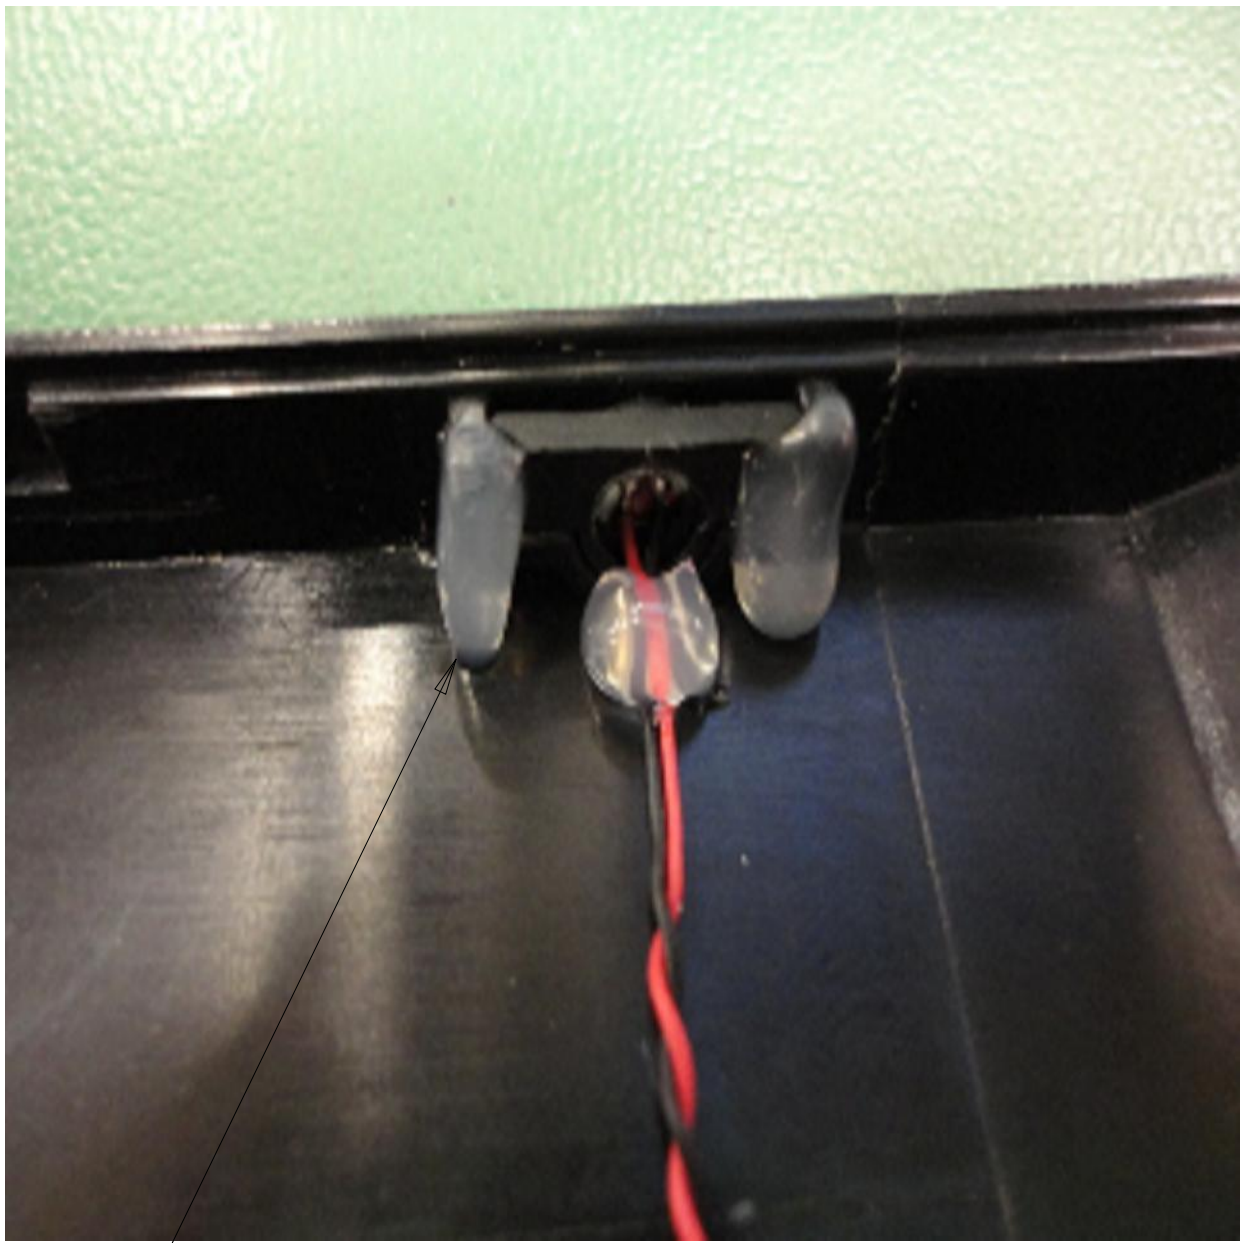
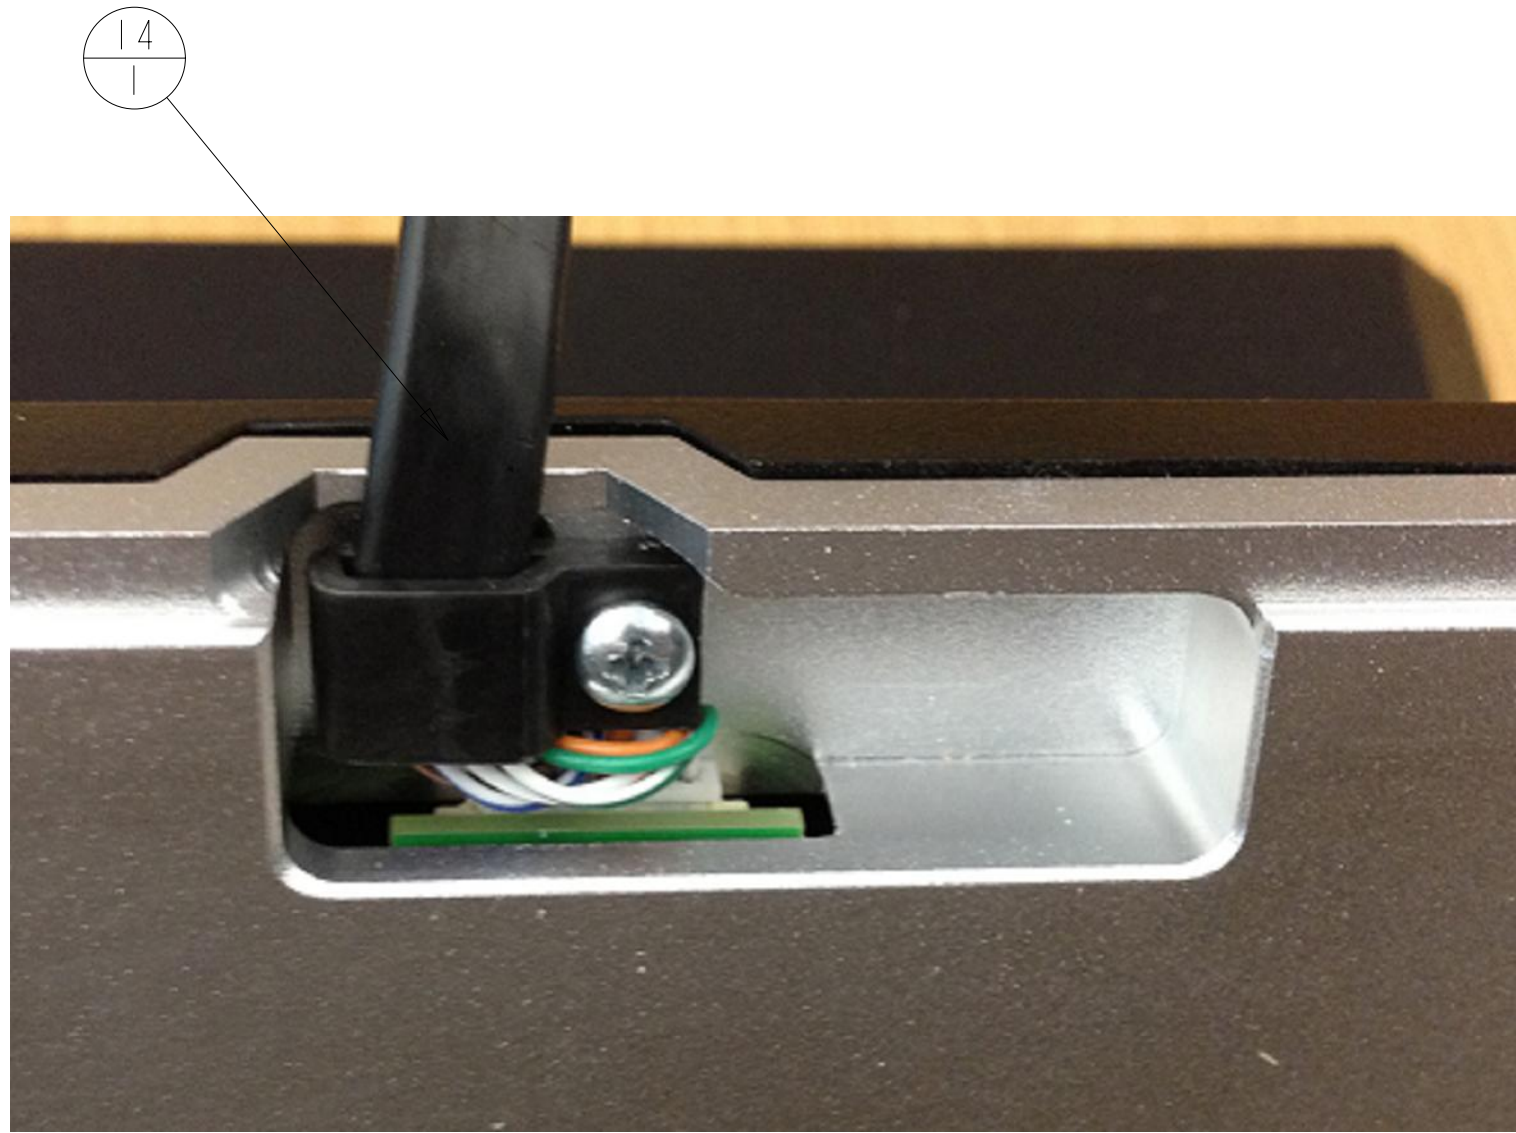


SCALE 2.000

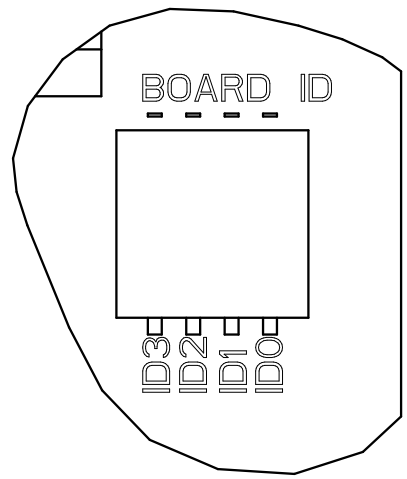

SCALE 4.000

SWITCH SETTINGS					
ID	MODEL	ID3	ID2	ID1	ID0
0XA	7" TABLE	1	0	1	0

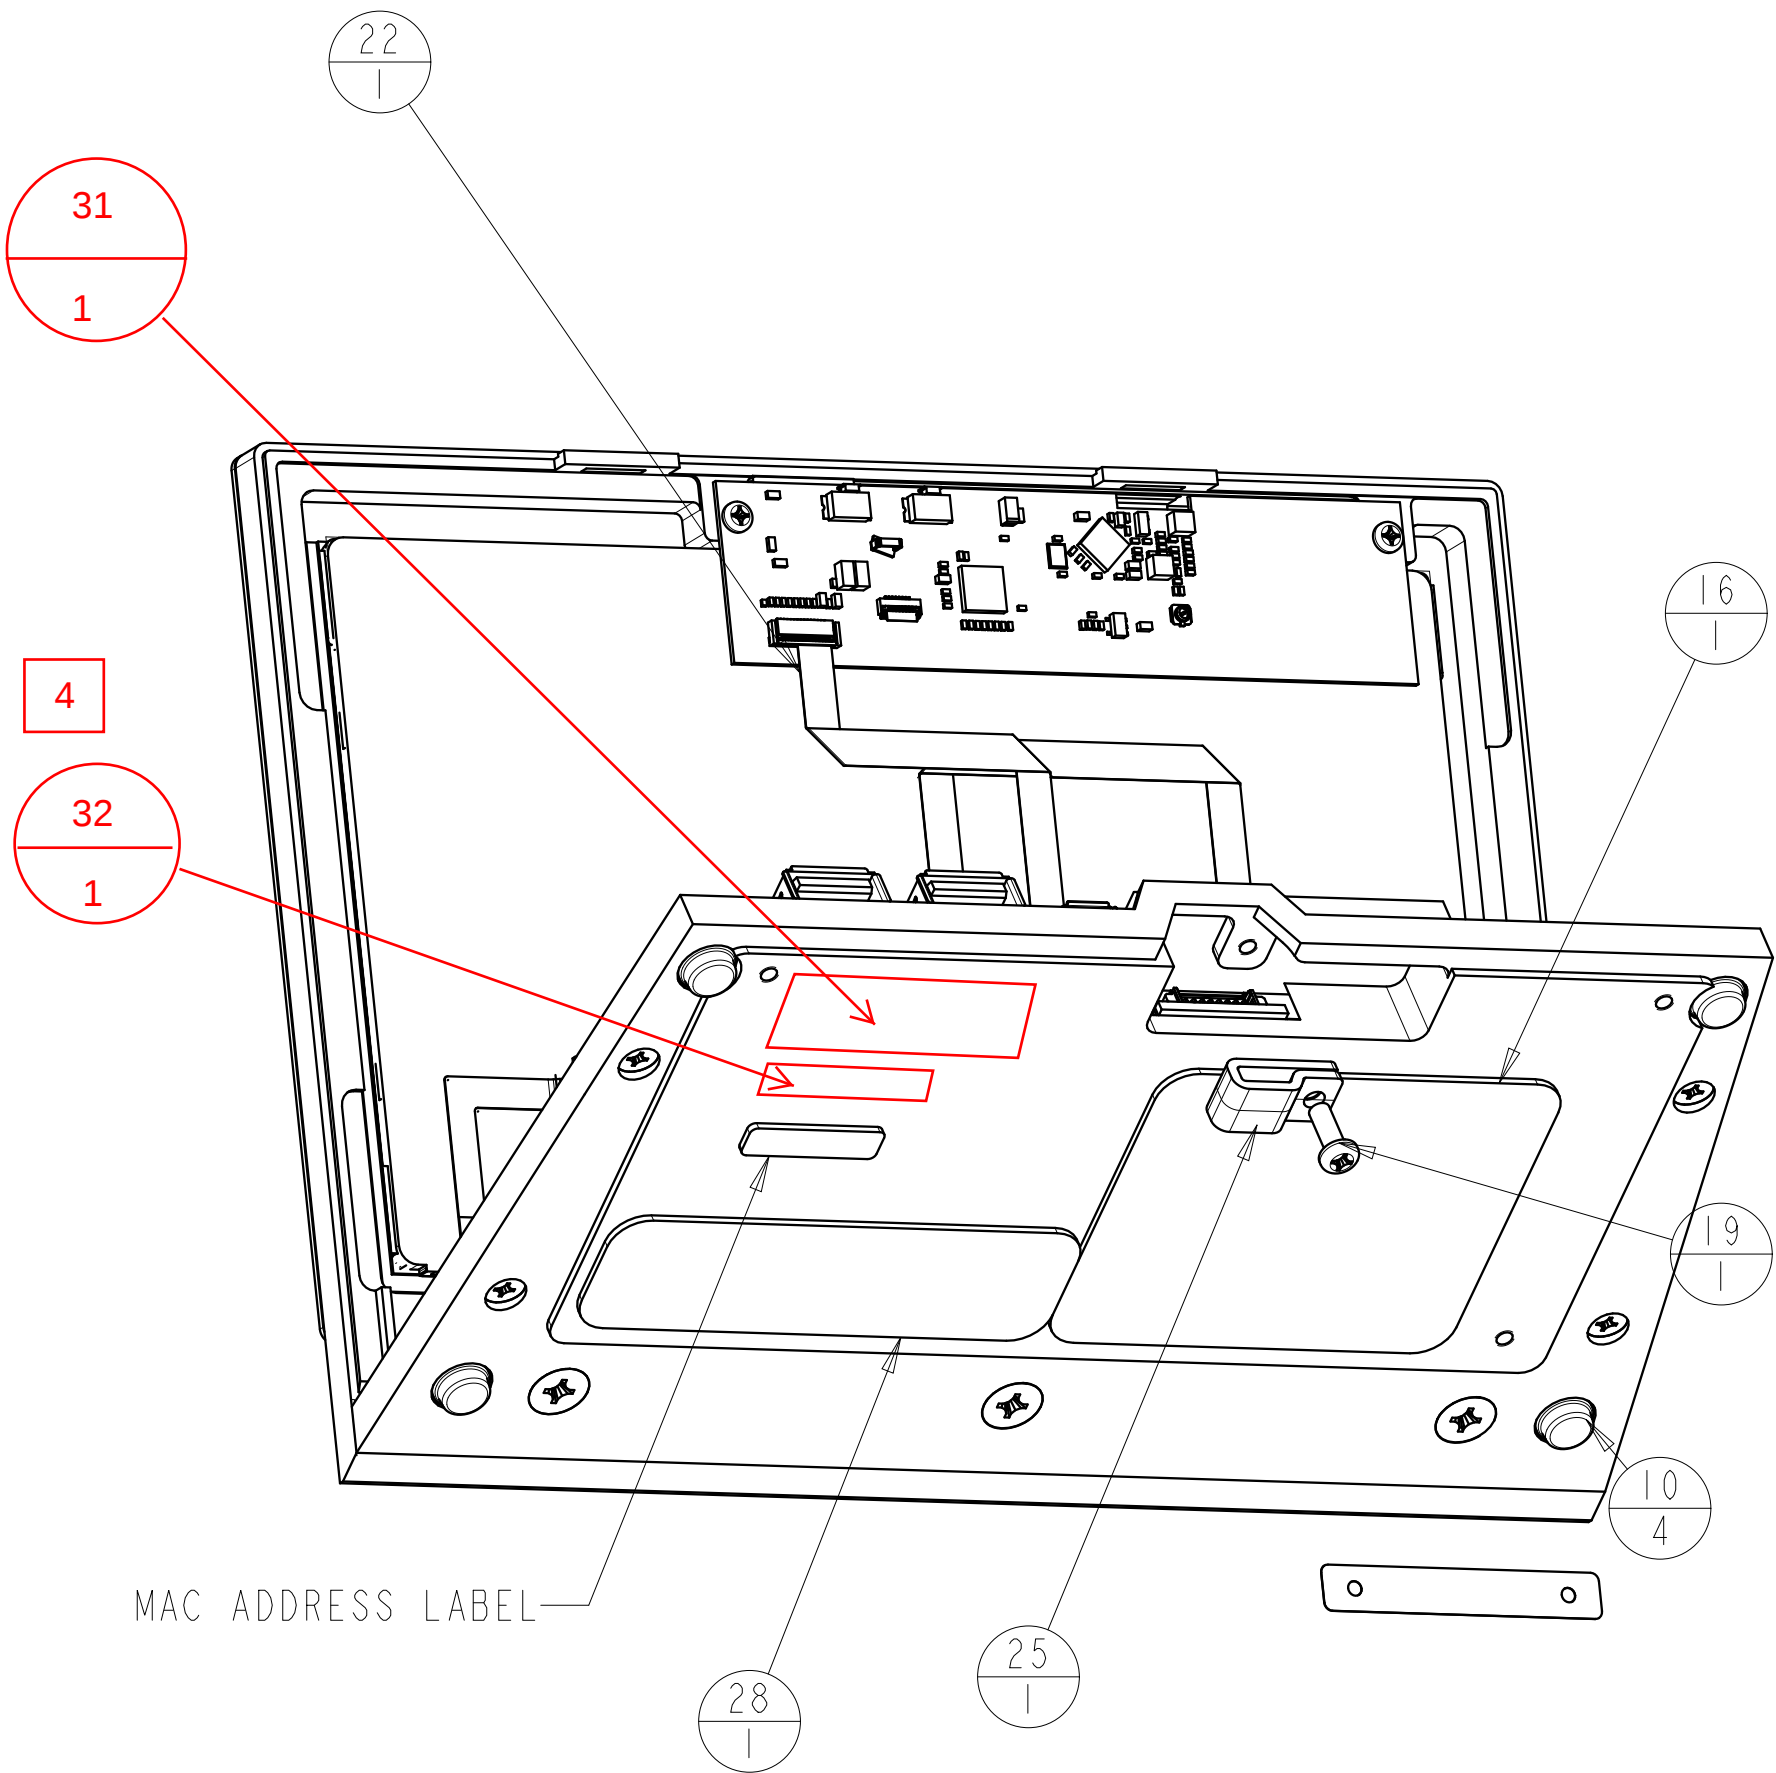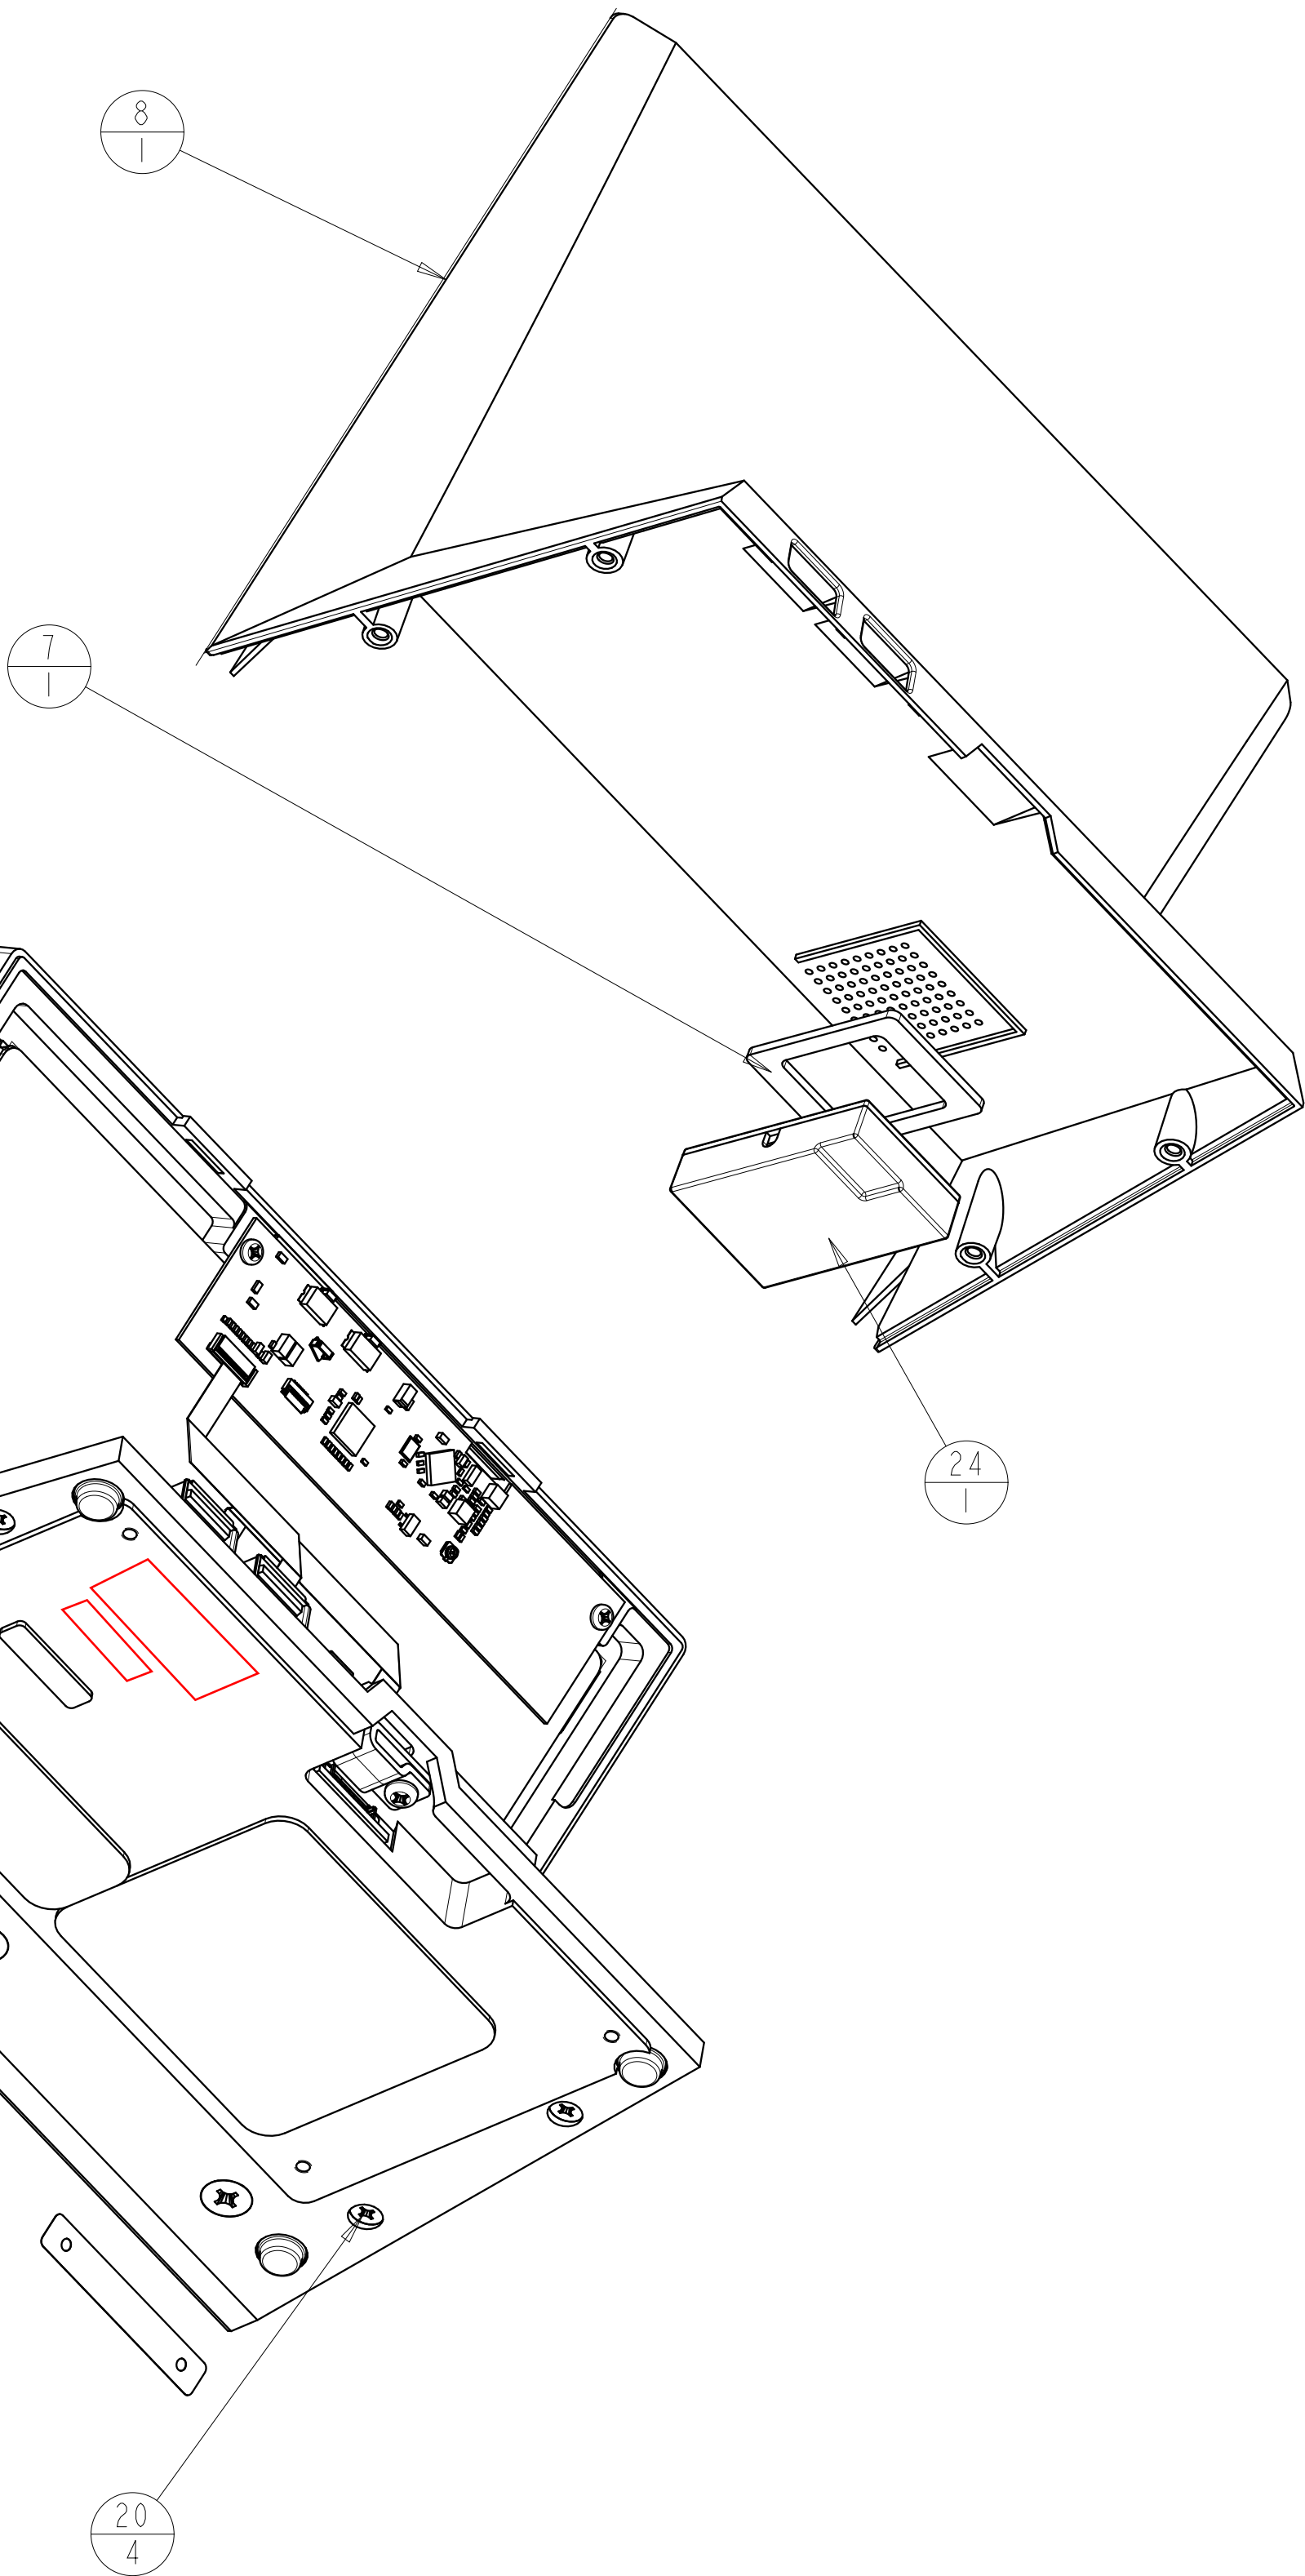

MAC ADDRESS LABEL

NOTICE: This drawing is the property of AMX LLC. All information contained herein this is not generally known shall be confidential except to the extent the information had been previously established. This drawings may not be copied, reproduced, or used as the basis for manufacture or sale without written permission.

AMX LLC
3000 RESEARCH DRIVE
RICHARDSON, TX 75082

ENGINEERING ASSEMBLY,
TOUCH PANEL,
7" MODERO PANORAMIC TABLETOP

SIZE	DRAWING NUMBER	EA5968-04	REV	Q-R1
D				
SCALE	1.000	SHEET	3 OF 3	

~~M-R1~~
~~P-R1~~