

CHANGE ORDER

ROUTING BY DWG INFO			
FOR	DIVN	DEPT	COPY
BOM/EDS			
LOGISTICS			
STANDARDS			
MFG. ENGRG.			
MTL CONTROL			
QC DOC CONTROL			
PLANNING			
COG ENGINEER			
TOTALS			
RELEASE DATE			

TYPE OR PRINT WITH BLACK PEN OR PENCIL

ENGR SECT-DEPT NO. LRC Engineering 450472	HOLD FOR ENGRG APPROVAL ☒ YES, PROD. ENGR ☒ YES, SE ☐ YES, COG. ENGR ☐ NO	☒ REGULAR ☐ EMERGENCY ☐ GROUP ☐ ACCUMULATIVE ☐ RELATED ☐ CONJUNCTION		AW/PS CRITICAL ITEMS IS CRITICAL ITEM AFFECTED? ☐ YES ☐ NO ☒ NA
PRODUCT NAME SD-700	SPECIAL CONFIGURATION CONTROL ☐ YES ☒ NO	SOFTWARE AFFECTED? ☐ YES ☒ NO		ATTACHMENTS: ☐ OTHER (EXPLAIN) ☐ MARKED PRINT ☒ NONE
DESIGN TO CHARGE TO 104965 595D116759	INTERDIVISIONAL ☐ YES ☒ NO CONFIGURATION CONTROL			

PARTS LIST CHANGES (USE FORM 5200-002 FOR SUPPLEMENTS.)[illegible]

PIGGYBACK

AFFECTED DRAWING SHEETS 53 and 54

[illegible]


QTY PER	DASH NO.
1	1
1	2
1	3
1	100

PICTORIAL CHANGES (USE FORM 5200-003 FOR SUPPLEMENTS.)

DASH NO.	RELATED ASSEMBLIES TO BE CHANGED BY PROD CONTROL				DOCUMENTS TO BE CHANGED BY DESIGN DEPT C.O.			
					☐ DWG ☐ PL	☐ DWG ☐ PL		
					☐ DWG ☐ PL	☐ SPEC		

[illegible]

VALIDATION:		REMARKS:		PRINT NAME AND SIGN INITIALS.		DATE	DEPT. NO.	EXT.
DESIGN JAN 30 2001		CHANGE DO160D		COGNIZANT ENGINEER				
		CATEGORIES ON		PRODUCT ENGINEER T. Europa		1/19 2001	450472	4718
		-40 AND -41 AGREE TO		STANDARDS ENGINEER (SE) V. GHERA		1/24/01	450850	4736
DOCUMENT CONTROL FEB 09 2001		WITH QUAL.		MANUFACTURING ENGINEER V. Labrozzi		2/2/01	440921	4949
				SOFTWARE QA (SQA)				
CCB FEB 02 2001 SATCOM				CONFIGURATION MANAGEMENT				
				PLANNING J. Bays		2/9/01	125100 530750	8768
				PRODUCTION CONTROL PT STATUS CHECKED ☐ YES ☐ NO				
CCR NO.		FIELD SHOP ☐ REVIEW		SECTION HEAD APPROVAL (FOR ECO & AW/PS ITEMS)				
IS MARK UP ☐ YES PRINT IN FACTORY? ☒ NO		NHA 7516118		DEPT MGR APPROVAL (FOR AW/PS ITEMS/ITT)				
CONT NO.		ECP/NOC/COORD. MEMO NO.		QE SUPERVISOR (PROD. CRITICAL ITEMS) P. McKeon		2/9/01	435200 430220	7838
CO. 24485		☐ NA	CLASS OF CHANGE ☒ CL I ☒ CL II	GOVT/CUSTOMER REP APPROVAL (WHEN REQD)				
SHEET 1 OF 3		PROD. LINE NO. 5115		ENGR NO.		TITLE PLATE, ID		DRAWING/SPEC NO. 7021570 -
						SYM CHANGE BE 1 BF		TO

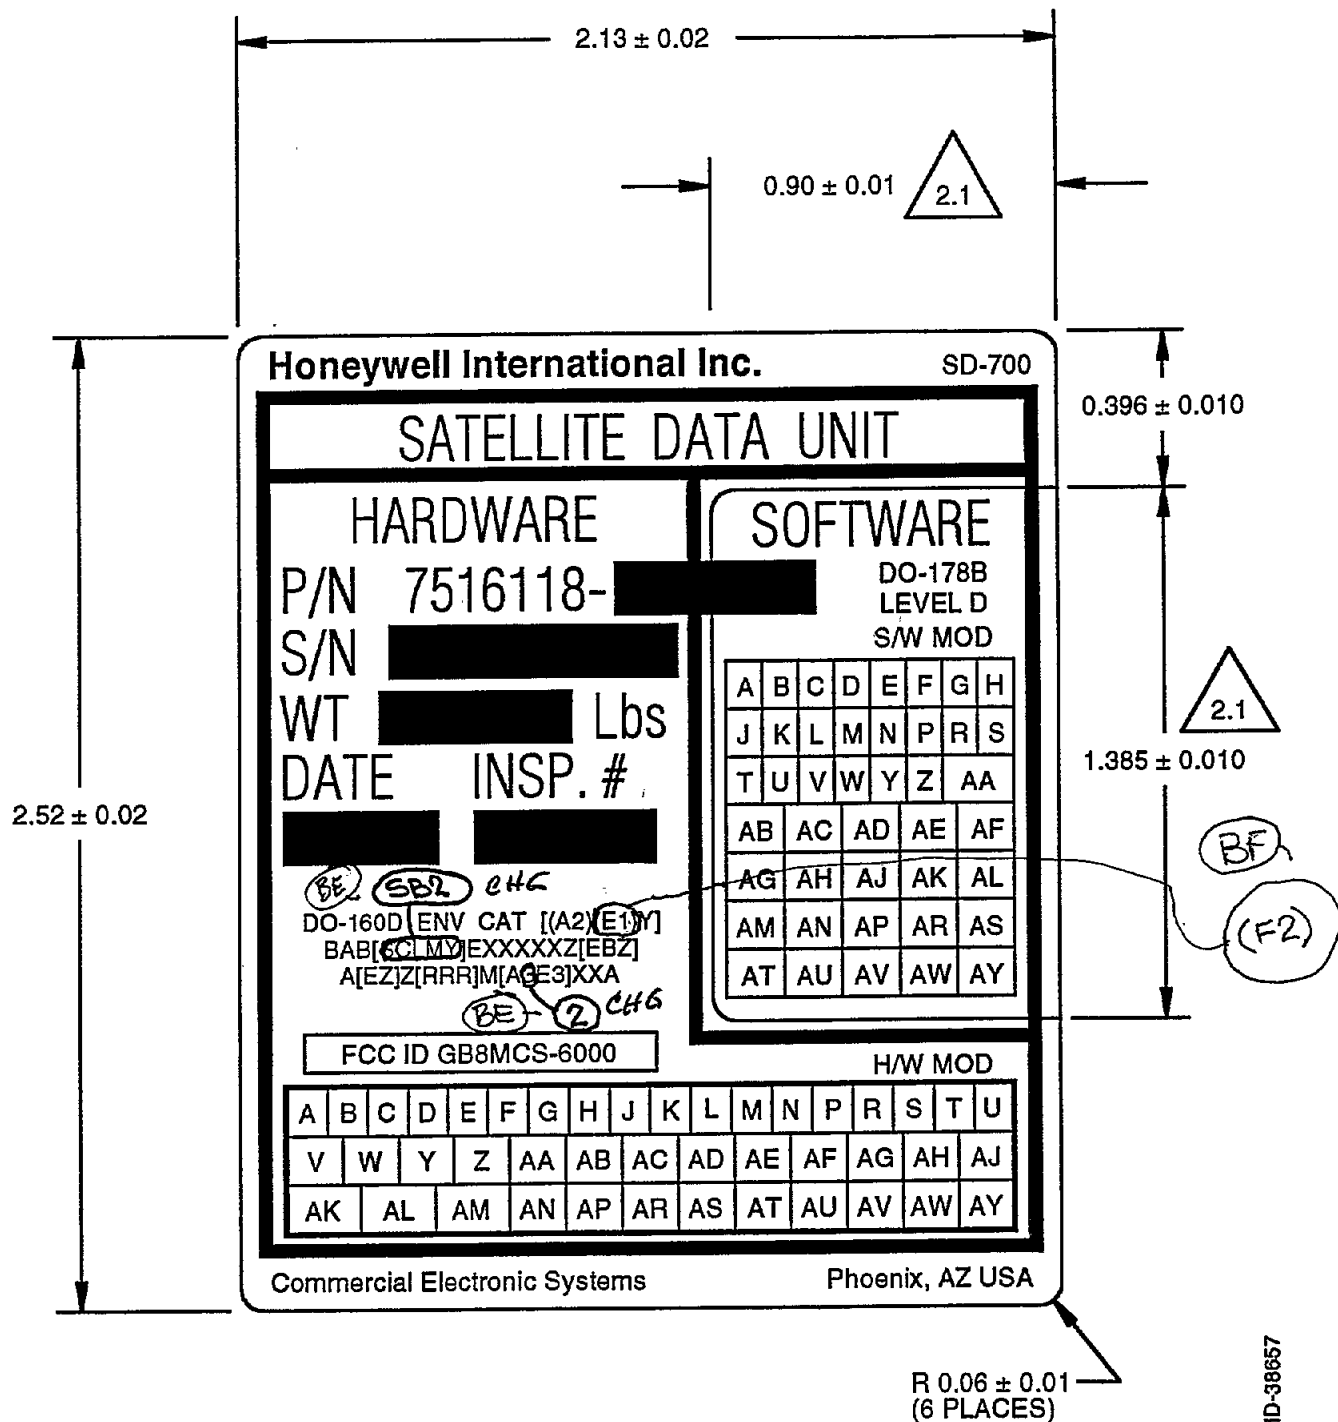

CO. 24485 SH 2 OF 3

FIGURE 51
7021570-40

CO. 24485 SH 2 OF 3

ID-38657

Honeywell

SEE FIRST SHEET FOR
CONTRACT NUMBER. USE OR
DISCLOSURE OF INFORMATION ON
THIS SHEET IS SUBJECT TO THE
RESTRICTIONS ON THE FIRST
SHEET OF THIS DOCUMENT.

SIZE

A

CAGE CODE

55939

DRAWING NO.

7021570

SCALE

NONE


UNIT WT

SHEET

53

REV

BC

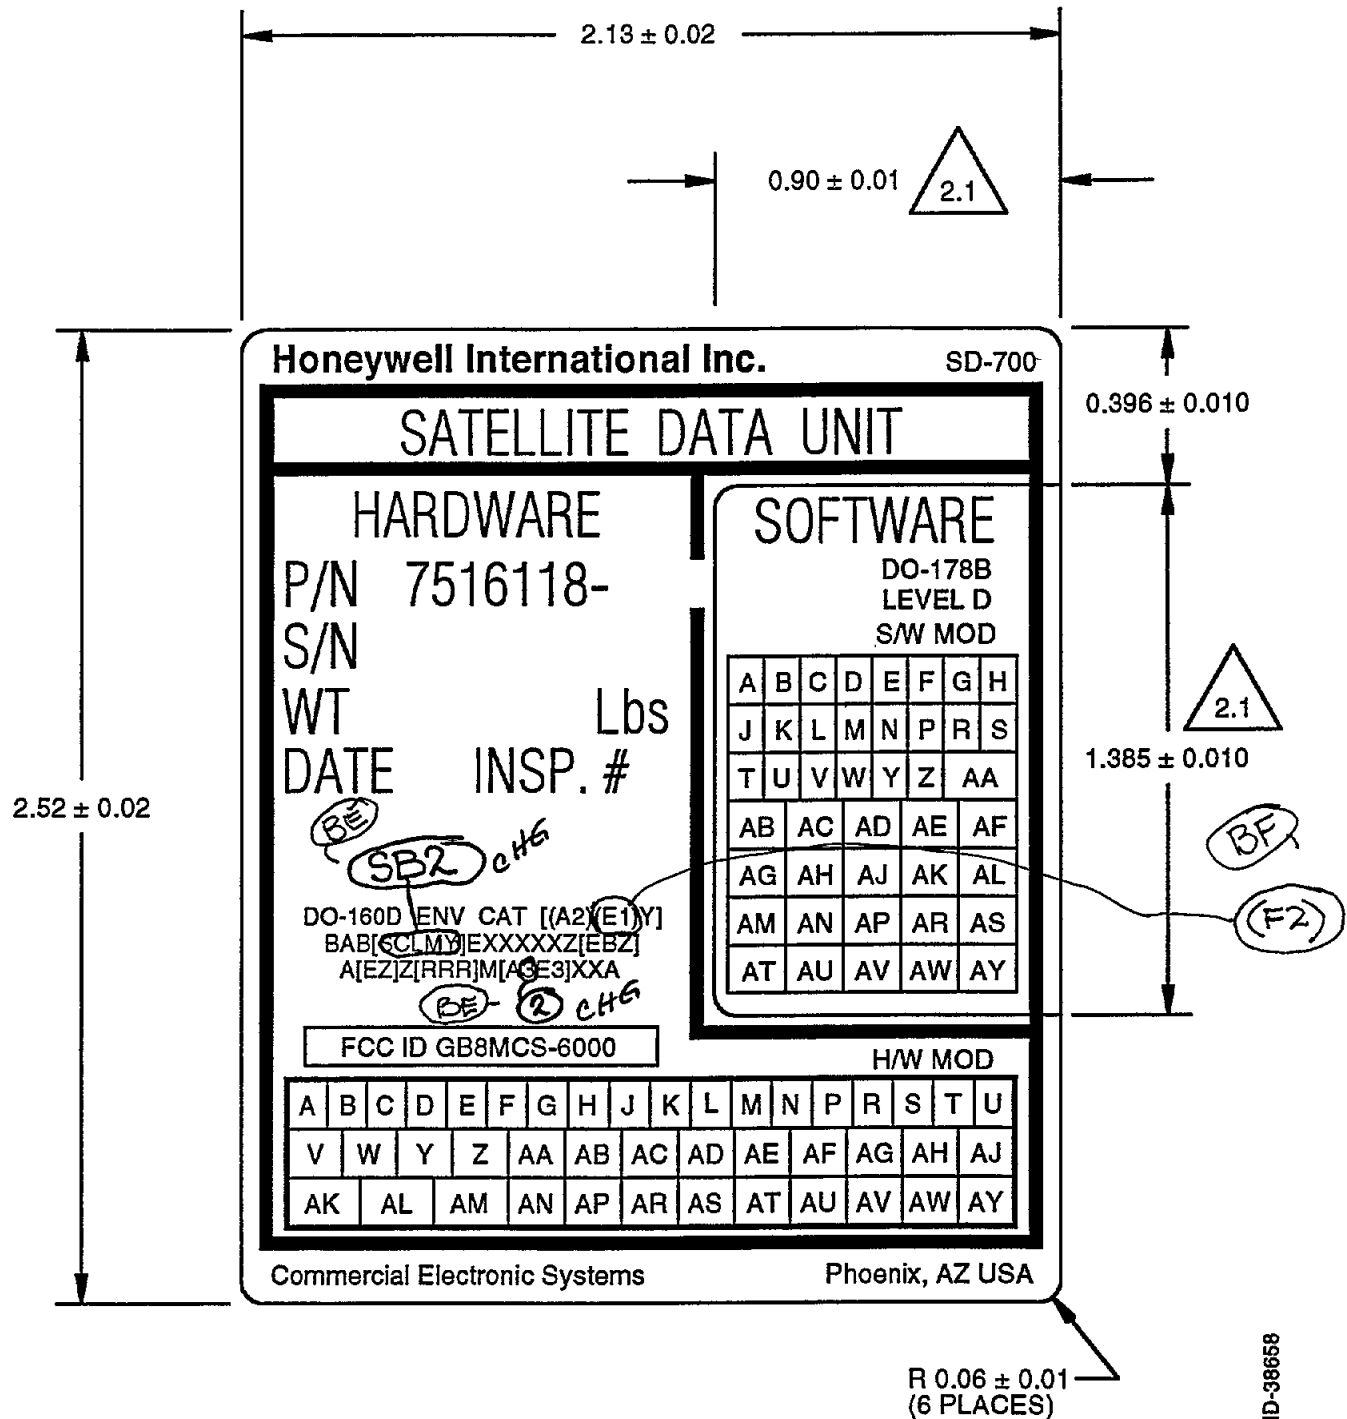

Honeywell

SEE FIRST SHEET FOR
CONTRACT NUMBER. USE OR
DISCLOSURE OF INFORMATION ON
THIS SHEET IS SUBJECT TO THE
RESTRICTIONS ON THE FIRST
SHEET OF THIS DOCUMENT.

SIZE

A

CAGE CODE

55939

DRAWING NO.

7021570

SCALE

NONE

UNIT WT

SHEET

54