


△ RUBBER COLOR:GREY
(Pantone Cool Gray 9C)
ICON COLOR:WHITE

△ ~~RUBBER COLOR:CLEAR~~
~~ICON COLOR:BLACK~~

~~RUBBER COLOR:GREY~~
(Pantone Cool Gray 9C)
~~ICON COLOR:BLACK~~

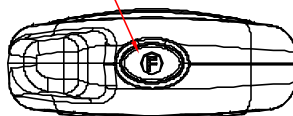

△ ~~40.98~~
41.93

~~CASE COLOR:GREY~~
(Pantone 8401C)

△ CASE COLOR:GREY
(Pantone 8401C)

△ LENS COLOR:GREY
(Pantone 8401C)

~~△ LENS COLOR:GREY~~
(Pantone 8401C)


△ RUBBER COLOR:GREY
(Pantone Cool Gray 9C)
ICON COLOR:WHITE

~~△ RUBBER COLOR:GREY~~
(Pantone Cool Gray 9C)
~~ICON COLOR:BLACK~~

~~△ RUBBER COLOR:CLEAR~~
~~ICON COLOR:BLACK~~

△ ~~ENGRAVING<RAISED=0.2>~~
ENGRAVING<CAVE=0.2,FLASH>
CHANGE CORE<CAVE=0.2,FLASH>

REVISIONS				
REV.	ACC.	DESCRIPTION	DRN.	DATE
△1		MODIFY SURFACE	SRZ	5/16/06
△2		CORRECT DWG	SRZ	6/21/06
△3		CORRECT DWG	SRZ	6/28/06
△4		By raised becomes cave	SRZ	7/10/06
△5		CHANGE LENS LOGO	SRZ	7/20/06
△6		CORRECT LENS P/N	SRZ	7/25/06
△7		MODIFY ICON	SRZ	7/26/06



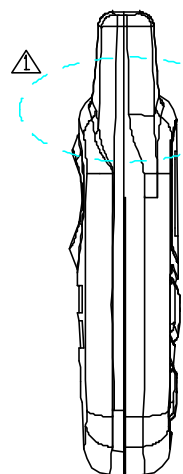


△ ~~AUTOSTART~~

PRINTING COLOR: SILVER

△ ~~RUBBER COLOR:GREY~~
(Pantone Cool Gray 9C)

△ ~~67.29~~
67.65

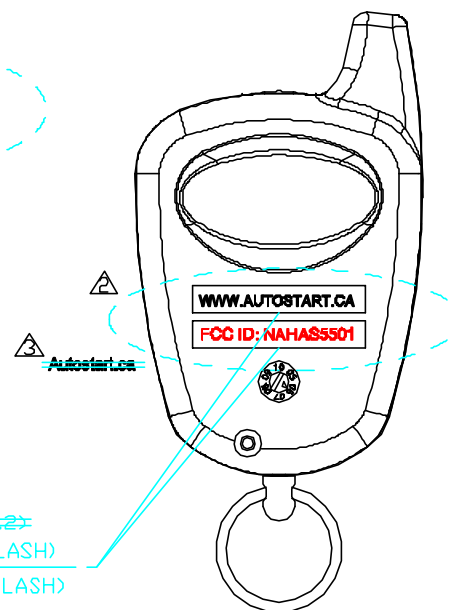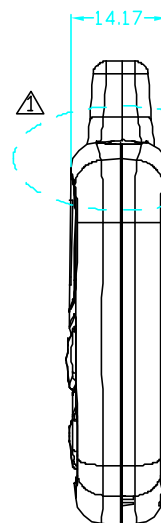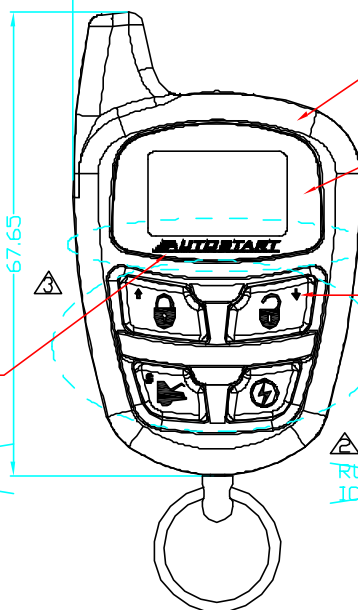

Distance please refer specification
of tolerance Units "mm"

UNIT	A	B	C
0-25	0.08	0.10	0.15
25-50	0.10	0.15	0.20
50-100	0.15	0.20	0.25
100-200	0.20	0.25	0.30

△ BODY MATERIAL: ABS+PC

BODY MATERIAL: ABS

- Texture is same as MT-11010
- Radii will be 0.2 if not specified.

△ ~~△ SIDE TOP~~ NKSF18A0

△ ~~△ SCREW~~ MTF01408

PART	P/N
CASE	IASF4G01
PLATE	IHSF0000
KEY TOP	NKSF48A0
SIDE RUBBER	NKSF18B0
LENS	IRSF0800

PART	P/N
BAT CILP	MCSD1000
	IASD2000
BATTERY	CR2025*2
SCREW	MTF02008
KEY CHAIN	MA160000

SCALE: 1:1	UNIT: M/M	DRN BY SRZ	DATE 2006/5/15	NUTEK CORPORATION			
MATERIAL		CHK BY VICTOR		TITLE AS ASRF-5501G-100			
FINISH		APPD BY YGF		SIZE A4	DEPT	DRAWING NO 9510290	REV 7
CODE		SHEET	OF				

~~AS ASTR-2000-100 HHU~~