


APPENDIX E
SAMPLE LABEL

REVISIONS					
ZONE	REV.	DESCRIPTION	DATE	ECO NO.	APPROVED
	1	PRELIMINARY RELEASE	02/17/98		

NOTES: UNLESS OTHERWISE SPECIFIED

1. MATERIAL: ~~PA~~ Non METALIZED POLYESTER
2. FINISH: WHITE, TWO COLOR -- ~~BLACK COPY ON WHITE GREY BACKGROUND~~
3. THIS DRAWING IS NOT TO BE USED AS ARTWORK. SEE SHEET 2, FILM TOOL FOR ARTWORK.
4. ALL TEXT AND BARCODES WITHIN THE DASHED BOX'S ARE TO BE PRINTED ON DEMAND, AND HUMAN READABLE ONLY.

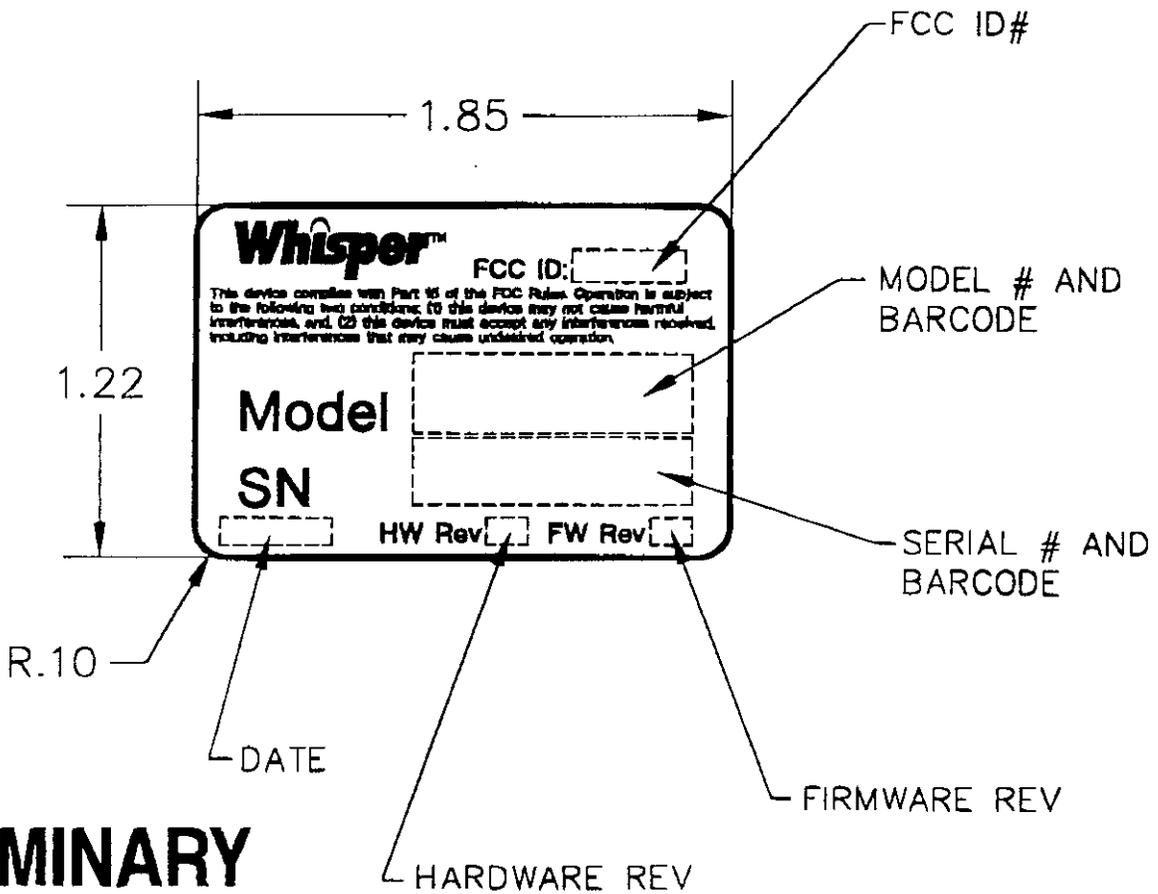


PRELIMINARY

DRAWING COPY

DATE ISSUED 2/17/98

UNLESS OTHERWISE SPECIFIED DIMENSIONS ARE IN INCHES TOLERANCES ARE: RADI: DECIMALS ANGLES XX ± .02 ± .XXX *		APPROVALS		DATE			825 STEWART DRIVE SUNNYVALE, CALIFORNIA 94089 (408) 738-8888 FAX (408) 738-2370 8500 PARKWOOD WAY RICHMOND, B.C. CANADA (604) 303-1800 FAX (604) 231-8888	
MATERIAL	SEE NOTE 1	DRAWN		K Bradley	02/17/98	FAB, ATW, LABEL, MODEL#/SER#/FCC		REV.
FINISH	SEE NOTE 2	CHECKED				SIZE	A	DWG. NO.
DIABLO RESEARCH CO. LLC CONFIDENTIAL A803004.DOC		SCALE		NONE	SHEET		1 OF 2	11039-0700

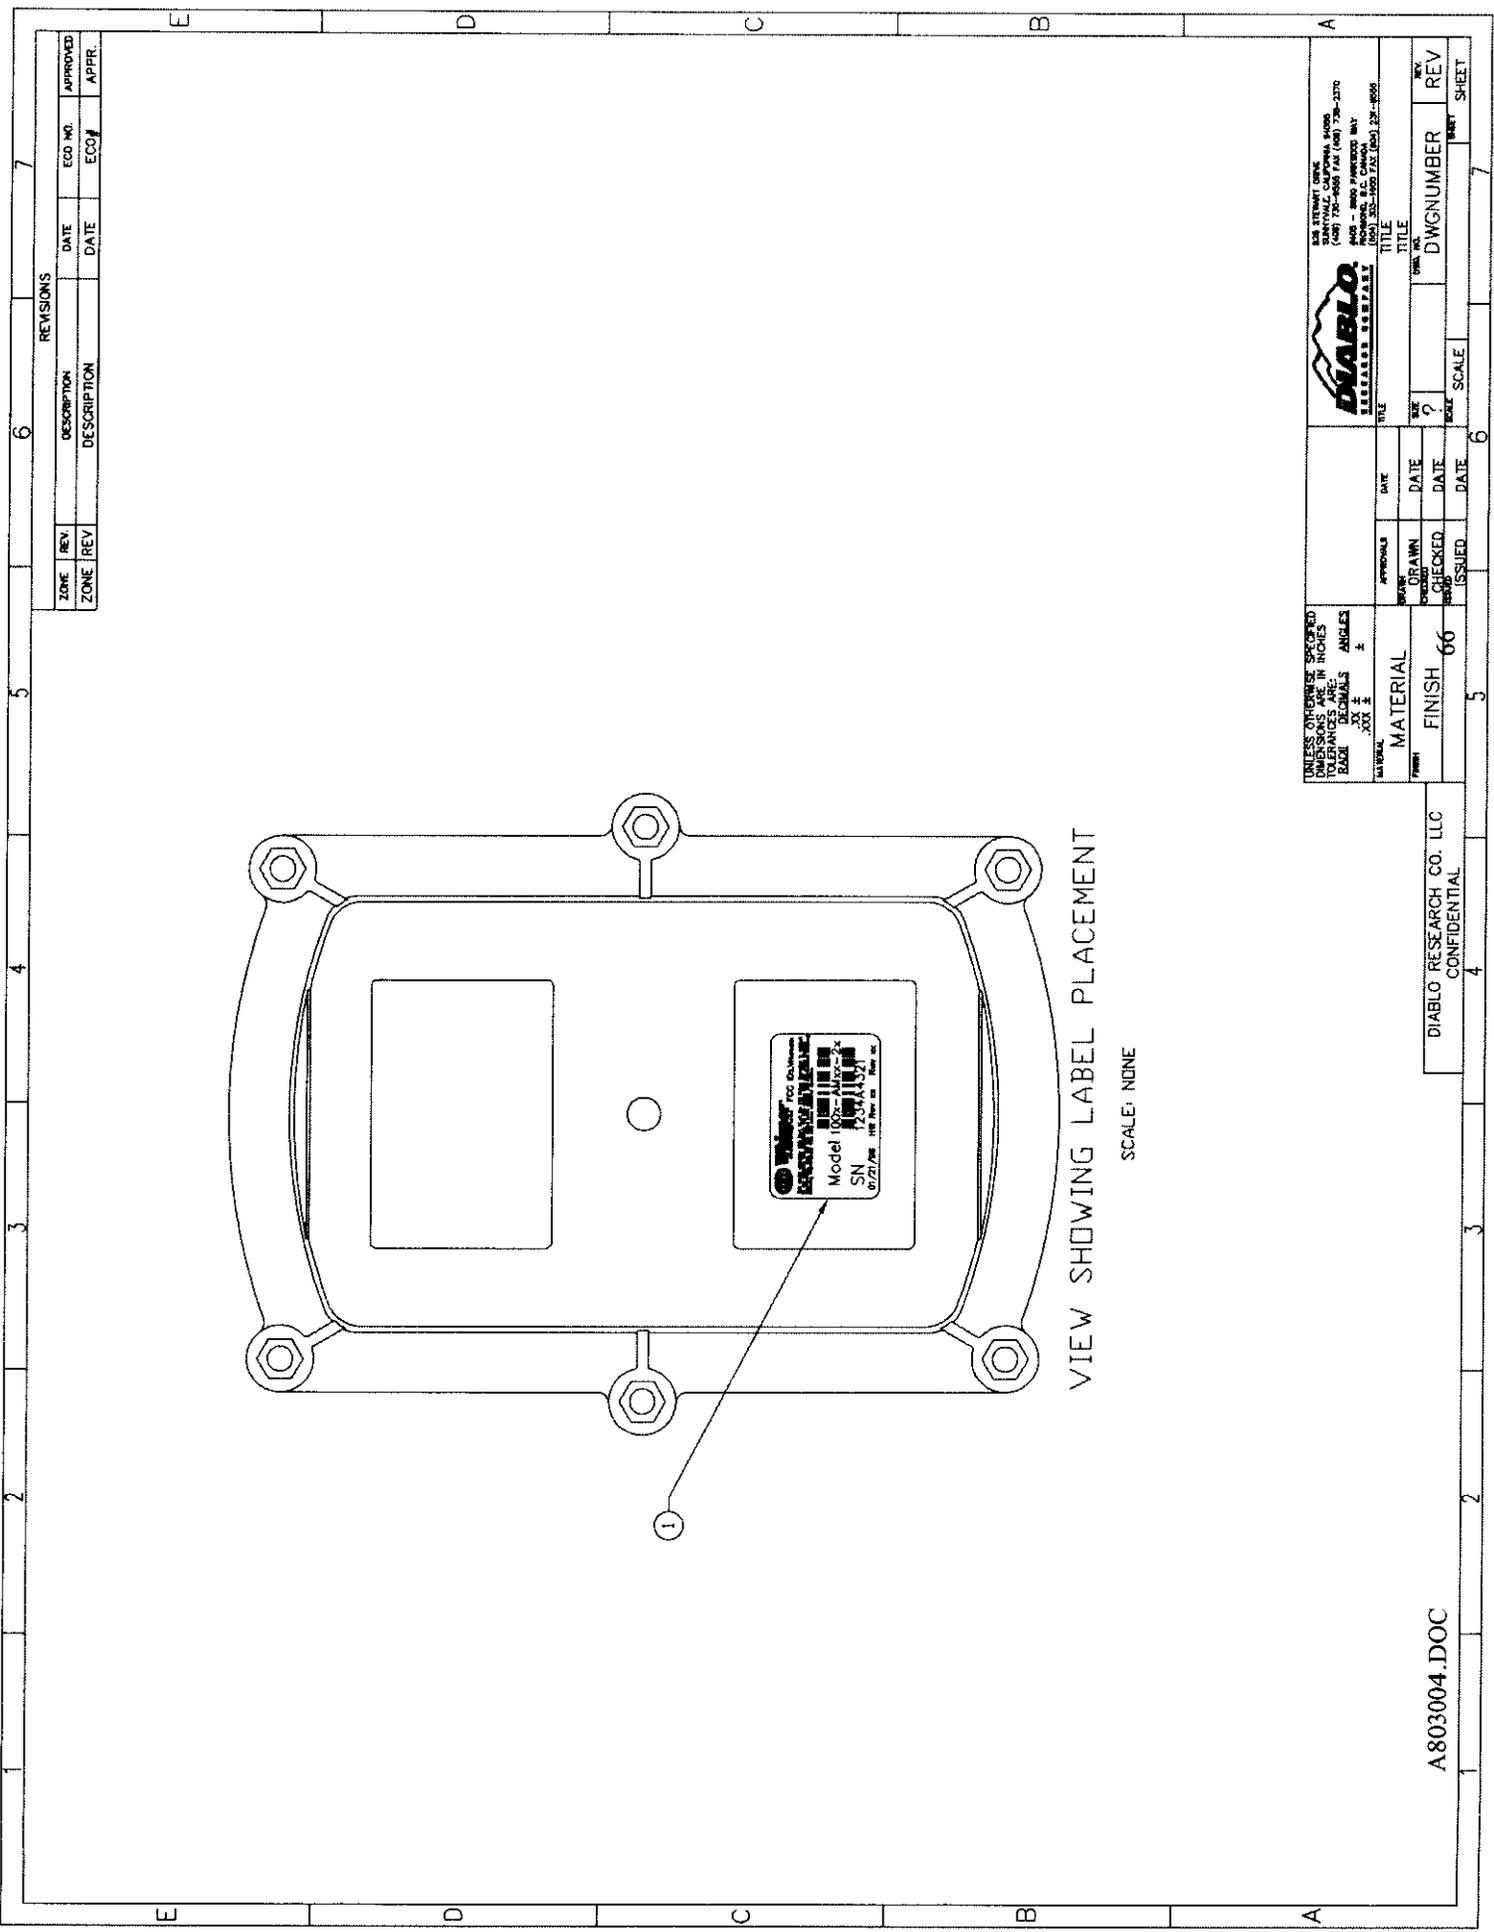

VIEW SHOWING LABEL PLACEMENT

SCALE: NONE

REVISIONS			
ZONE	REV	DESCRIPTION	DATE

ZONE	REV	ECO NO.	APPROVED

UNLESS OTHERWISE SPECIFIED DIMENSIONS ARE IN INCHES TOLERANCES ARE: FRACTIONS DECIMALS ANGLES XX ± .XX ± .XX ±			
MATERIAL		TITLE	
FINISH 66		DWG NUMBER	
APPROVALS	DATE	DATE	DATE
DRAWN	DATE	DATE	DATE
CHECKED	DATE	DATE	DATE
ISSUED	DATE	DATE	DATE


US PATENT & TRADE MARK OFFICE BARTON MALHEOR LLP (408) 735-6665 FAX (408) 735-2370 8400 - 8400 PARKWOOD WAY SAN JOSE, CA 95126 (408) 352-4500 FAX (408) 352-4605		TITLE DWG NUMBER REV
DIABLO RESEARCH CO. LLC CONFIDENTIAL		SCALE SHEET

A803004.DOC

REVISIONS					
ZONE	REV.	DESCRIPTION	DATE	ECO NO.	APPROVED
	1	PRELIMINARY RELEASE	02/17/98		

NOTES: UNLESS OTHERWISE SPECIFIED

1. MATERIAL: ~~Non~~ METALIZED POLYESTER
2. FINISH: MATE, TWO COLOR - ~~BLACK COPY ON~~ ~~WHEN GRAY~~ BACKGROUND
3. THIS DRAWING IS NOT TO BE USED AS ARTWORK. SEE SHEET 2, FILM TOOL FOR ARTWORK.
4. ALL TEXT AND BARCODES WITHIN THE DASHED BOX'S ARE TO BE PRINTED ON DEMAND, AND HUMAN READABLE ONLY.

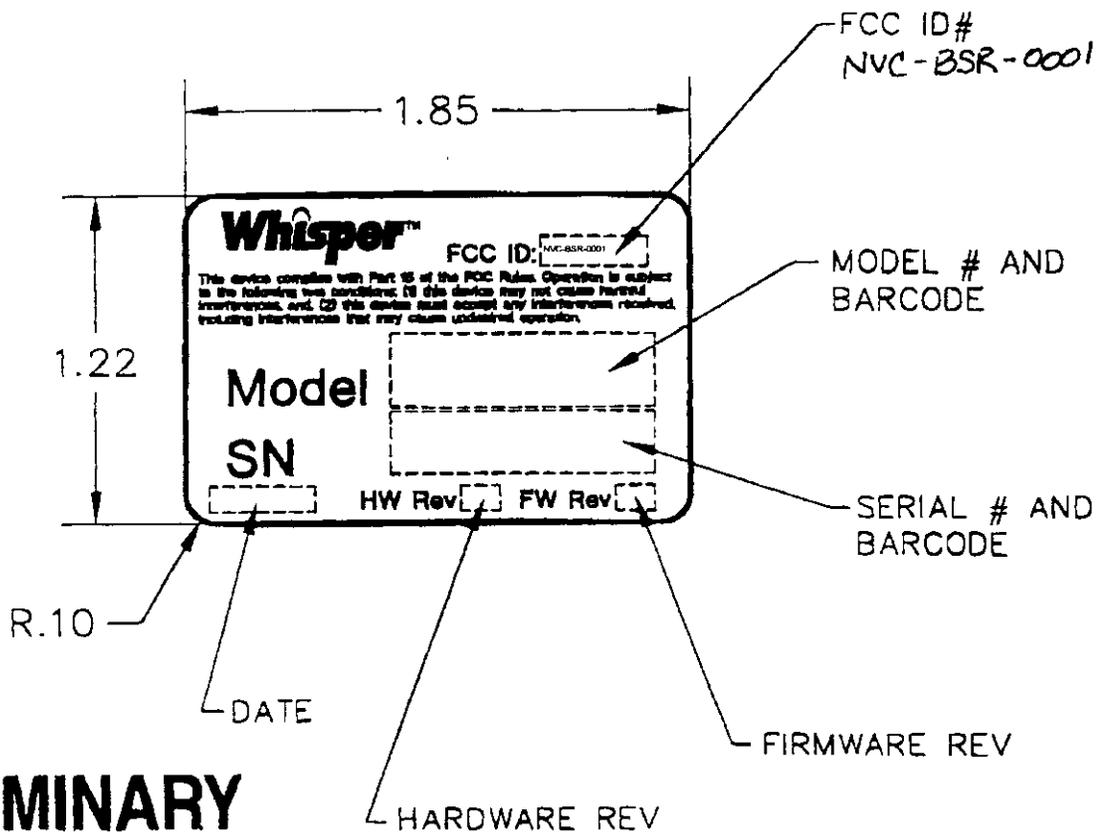

PRELIMINARY

DRAWING COPY

DATE ISSUED 2/17/98

UNLESS OTHERWISE SPECIFIED
DIMENSIONS ARE IN INCHES
TOLERANCES ARE:
SIZE DECIMALS ANGLES
BOTH .XX ± .02 *
XXX ±



625 STEWART DRIVE
SUNNYVALE, CALIFORNIA 94089
(415) 730-8888 FAX (415) 730-1378
8000 PARKWOOD WAY
BOCA RATON, FL. CANADA
(800) 303-8888 FAX (800) 231-8888

MATERIAL	APPROVALS	DATE
SEE NOTE 1	K Bradley	02/17/98
SEE NOTE 2		

SIZE	SCALE	DWG. NO.	REV.
A	NONE	11039-0700	1

DIABLO RESEARCH CO. LLC
CONFIDENTIAL
AS03004.DOC

SHEET 1 OF 2
05