


Model: VS100
 FCC ID: PGUWL1837
 IC: 4168A-WL1837

SCALE: 1 to 1

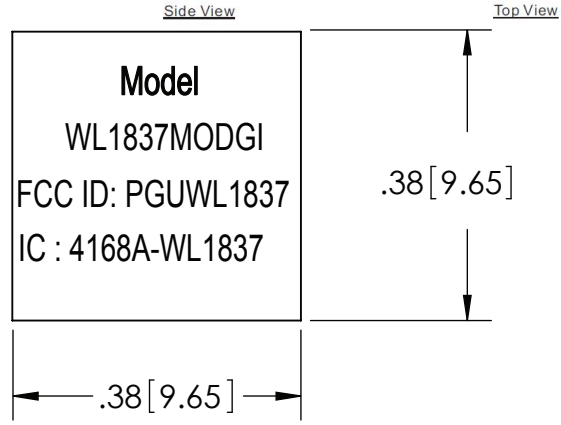

SCALE: 4 to 1

The proposed identification label will be affixed to the top of the RF shield on the WL1837MODGI radio module

Notes:

1. Size: approximately 3/8 in. x 3/8 in.
2. Materials: Non-conductive, appropriate for static sensitive electronic assemblies.
3. Adhesive: Peel and stick type, long term adhesion.

| | | |
|--|---------------------------------|-------------------------|
| | | |
| | | |
| | | |
| B | REDLINE for grant approval only | |
| A | RELEASE TO PRODUCTION | D* |
| VER | DESCRIPTION OF CHANGE | CHANGE NUMBER/APVD |
| D* SEE SAP DIR FOR CHANGE NUMBER, APPROVER NAME AND DATE OF APPROVAL | | |
| WelchAllyn® | | SCALE: 1:1 |
| | | ← 1.00" → |
| TITLE: AW, WI-FI MODULE LABEL | | SHEET 1 OF 1 |
| DRAWING NO: 30047736 | | DRW BY: J. CARYL |
| | | DATE: 2014-11-25 |
| PART NO. | DESCRIPTION | |
| 20142 | WI-FI MODULE LABEL | |
| | | |
| | | |