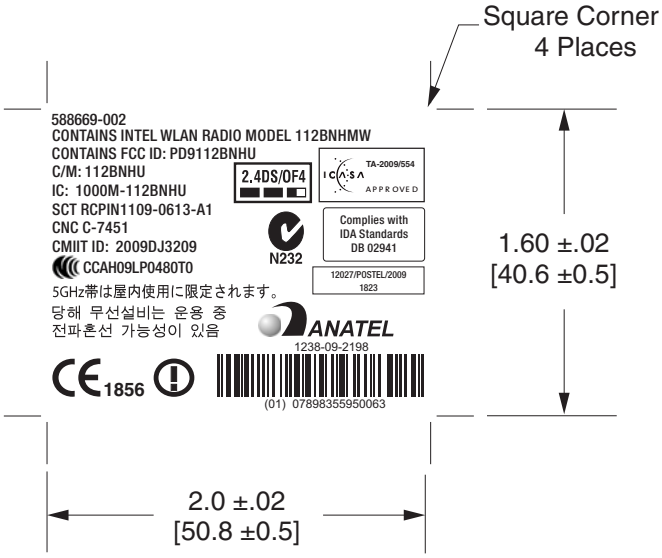

	SIZE	DRAWING NO.	REV
	A	588669	B
	DRAWN: J.L.	SCALE 1/1	

General specs, please refer to program documentation for specifics

NIK1.XHP_ENVY15.6MAG_AST_20090910_QUA

LABELS

1. Feature 1
2. Feature 2
3. MS OS (XP, Vista, W7) (MS OS only)
3b. MS OS (Vista, W7) Mini (MS OS only)
4. Processor
4a. Processor Mini
5. Keyboard Warranty
6a. Master Regulatory (Lion Vendors/Shanghai/Taiwan/Mexico/Brazil/Japan/Korea Models NOT ACMPS)
6b. Master Regulatory Chaeffler
7. Logo Seal
8. Battery (on bag)
9. Service Tag
9a. MS COA (MS OS only)
9b. MS COA Thunbnail (MS OS only)
11. Elitar (MS OS only)
12. WWAN ID
13. RCD
14. Country (Assist, Scrim, Recycle, Hg)
15. China GMS
16. China Comm (Mob, Tel)
17. China Rural Frame
18. China Rural Cover
19. Kor E Standby Cert (MS OS only)
20. Kor E Standby Wave
21. Taiwan Service (Tyr, Syr)
22. Japan Service CTO
23. India Battery
24. Graphics
25. Linux
26. Hitachi
27. SIM Location
Center label using crosshair.
Apply label starting in this corner.

- IMR Film Surface
- Mylar/IML Surface
- Molded Surface
- Painted Surface
- Metal Surface
- Chrome Surface
- Rubber Surface
- Markup Question
- Polycarbonate Label
- Icon Silk Screen Printed
- Icon Printed on IMR Roll
- Icon Laser Etched
- A Backlite Blue
- A Backlite Amber
- Chocolate
- Lighter than Argento
- Jack Black
- Black Licorice
- Lighter than Licorice
- Black Magic
- Chrome
- Platinum Silver
- IR Lens Material
- Metallic PMS 8403C
- LED Blue
- LED Amber
- Label hidden in bay or door

hp graphic plan

Nikita 1.X HP 15.6" Envy

2.2.09	5.5
Author: Kevin Hoffman, Kevin Hoffman@hp.com	Author: Kevin Hoffman, Kevin Hoffman@hp.com
Andrew Interrante	Kevin Mancuso
Design Manager Signature:	Surface Mg
Date Made:	Surface Mg

NIK1.XHP_ENVY15.6MAG_AST_20090910_QUA: Illustrator v.CS3/.5

hp restricted
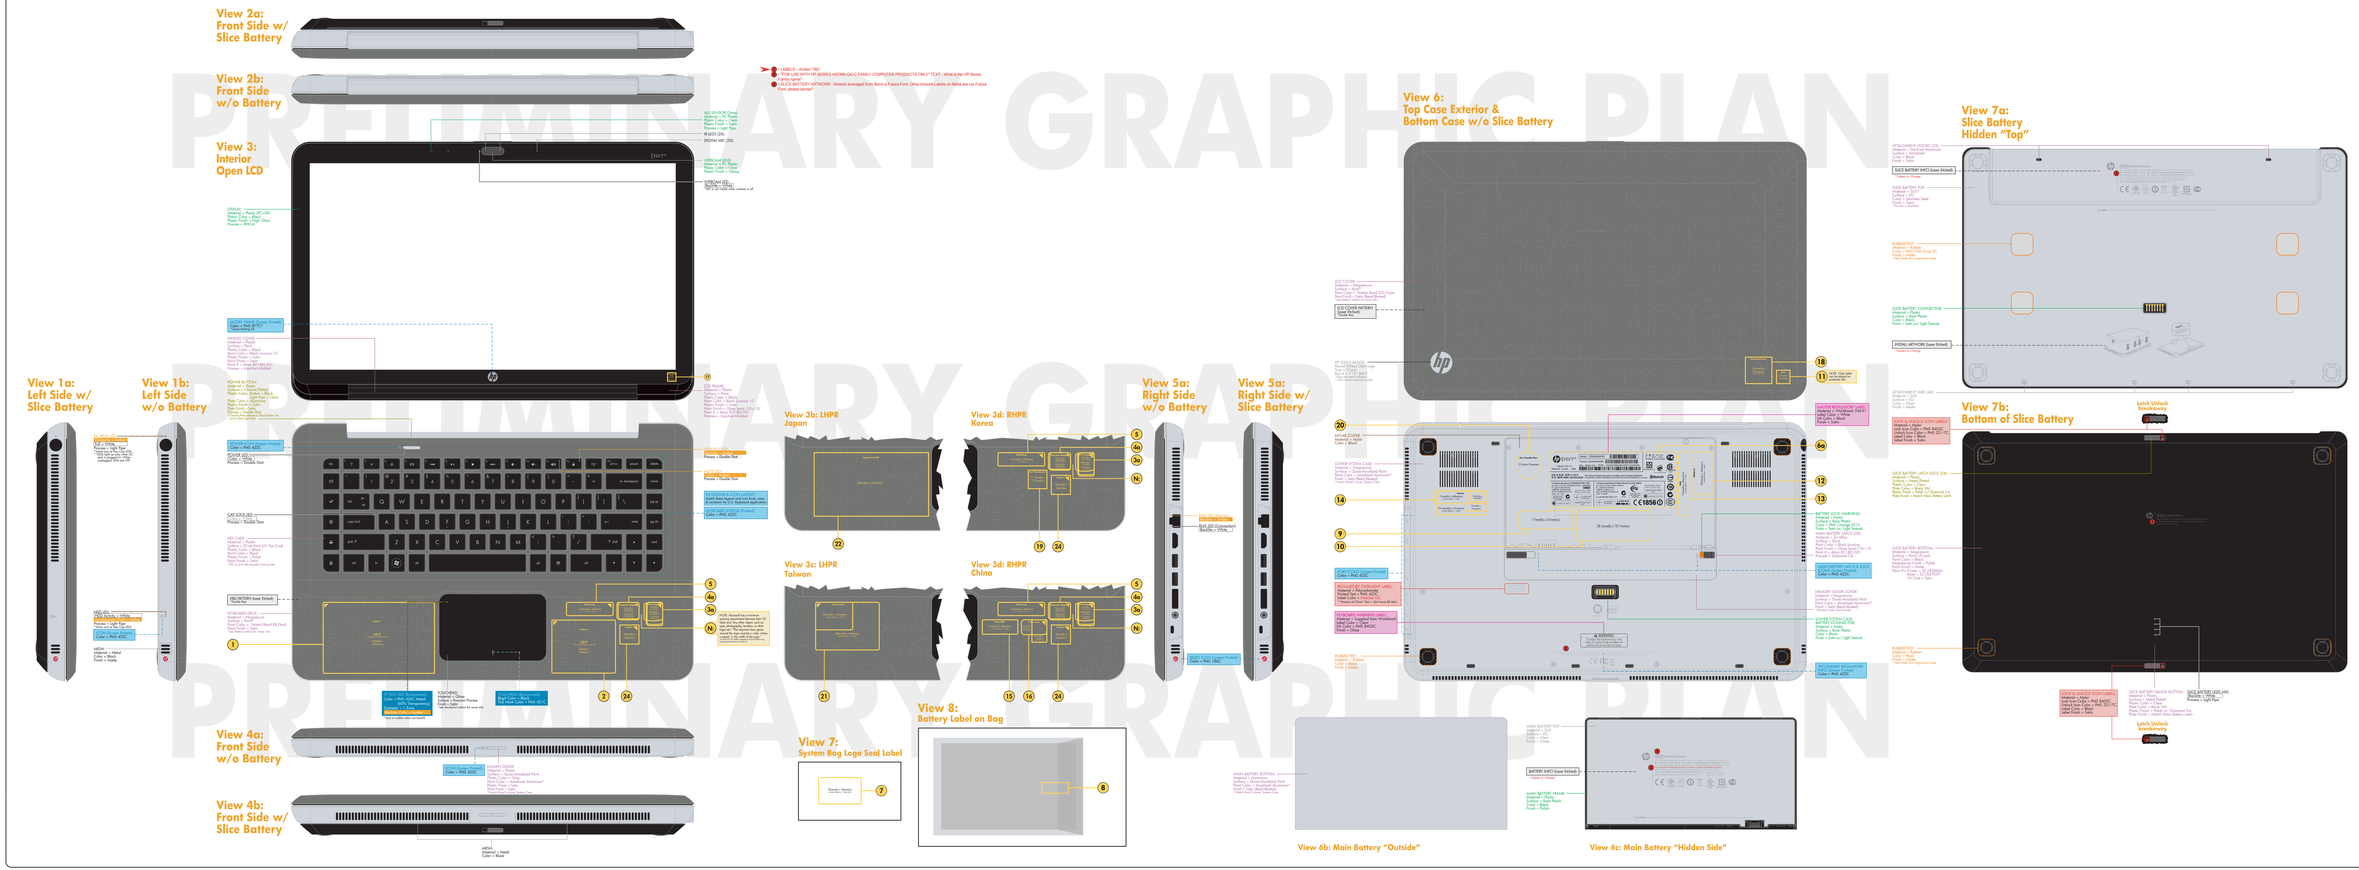
PRELIMINARY GRAPHIC PLAN